

Leflore  
G 28  
11-8-80

MISSISSIPPI  
BOARD OF WATER COMMISSIONERS  
416 North State Street  
Jackson, Mississippi 39201

CODED

WATER WELL DRILLERS LOG  
BUTANE GAS COMPANY

11-8-80 19 OF GREENWOOD Leflore  
date well completed film name county well located

LANDOWNER:	description of formations encountered	from	to
Brown Farms			
Schlatter	Sand	13	20
(mailing address)	Sand + Pea Gravel	30	60
	Sand + Gravel	60	100

WELL LOCATION:  
sec. 4 T 20N R 1 E  
S S W  
2 1/2 miles SE of Schlatter  
(distance) (direction) (nearest town)

CODED

WELL PURPOSE: Cat Fish  
(home, irrigation, municipal, industrial)


- WELL COMPLETION DATA:
- (1) diameter (inches) 16"
  - (2) total depth (feet) 100
  - (3) static water level (feet) 18 below top of ground.
  - (4) casing Steel, 60',  
(material) (depth)  
16" (size) if telescope see back.
  - (5) screen 40', 60'  
(length) (depth to top)  
16" (size) Steel (material)
  - (6) pump 40 HP, 2000 (yield gpm)  
Diesel (type power)
  - (7) electric log No (yes or no)
- (organization running log)
- (8) how well bottom plugged Steel Plate

DRILLERS REMARKS:

DEPT. OF NATURAL RESOURCES  
BUREAU OF LAND & WATER RESOURCES  
NOV 17 1980  
RECEIVED

If well telescopes please sketch and show depths.

GROUND LEVEL

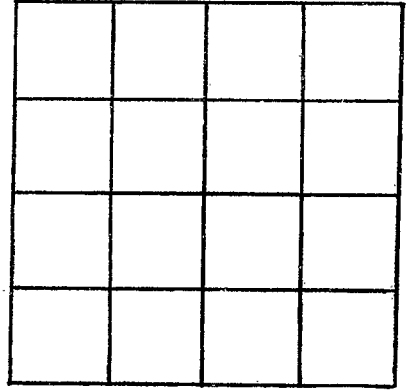

SECTION \_\_\_\_\_

Please indicate well location X.

ADDITIONAL INFORMATION

If more than one screen,  
show locations of each on sketch.