

Lefflore
 G 34

MISSISSIPPI DEPARTMENT OF NATURAL RESOURCES
 Bureau of Land and Water Resources
 Southport Mall
 P.O. Box 10631
 Jackson, Mississippi 39209

CODED

2

WATER WELL DRILLERS LOG

BUTANE GAS CO. OF GREENWOOD

POST OFFICE BOX 1125

GREENWOOD, MISS. 39001

3-31-82 date well completed

Lefflore county well located

LANDOWNER:	description of formations encountered	from	to
<i>Bary Farms</i>	<i>clay</i>	<i>1</i>	<i>25</i>
(mailing address)	<i>sand</i>	<i>25</i>	<i>40</i>
WELL LOCATION:	<i>sand & clay</i>	<i>40</i>	<i>60</i>
sec. <i>7</i> T <i>20</i> N R <i>1</i> E	<i>fine sand</i>	<i>60</i>	<i>85</i>
<i>6</i> miles <i>NW</i> of <i>Greenwood</i>	<i>sand & gravel</i>	<i>85</i>	<i>105</i>
WELL PURPOSE:			
<i>irrigation</i> (home, irrigation, municipal, industrial)			
WELL COMPLETION DATA:			
(1) diameter (inches) <i>16"</i>			
(2) total depth (feet) <i>105</i>			
(3) static water level (feet) <i>20</i> <small>below above</small> top of ground.			
(4) casing <i>Steel, 65'</i> (material) (depth) <i>16"</i> (size) if telescope see back.			
(5) screen <i>40', 65'</i> (length) (depth to top) <i>16", steel</i> (size) (material)			
(6) pump <i>50</i> <i>1100</i> (HP) (yield gpm)			
<i>Diesel</i> (type power)			
(7) electric log <i>No.</i> (yes or no)			
<i>No.</i> (organization running log)			
(8) how well-bottom plugged <i>Steel plate</i>			
DRILLERS REMARKS: <i>Charles Ramos</i>			


DEPT. OF NATURAL RESOURCES
 BUREAU OF LAND & WATER RESOURCES

APR 28 1982

RECEIVED

If well telescopes please sketch and show depths.

GROUND LEVEL

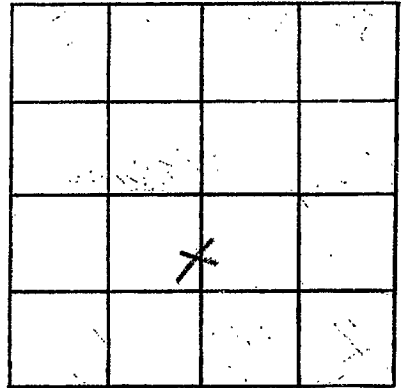

SECTION 4

Please indicate well location X.

ADDITIONAL INFORMATION

If more than one screen,
show locations of each on sketch.