

MISSISSIPPI DEPARTMENT OF NATURAL RESOURCES

Bureau of Land and Water Resources

Southport Mall

P.O. Box 10631

Jackson, Mississippi 39209

WATER WELL DRILLERS LOG

BUTANE GAS CO. OF GREENWOOD

POST OFFICE BOX 1135

CODED

*Leflore*  
*G 35*

*2-3* 19 *82* *Leflore*  
date well completed firm name county well located

LANDOWNER:	description of fomations encountered	from	to.
<i>Brown Farms</i>			
	<i>SAND</i>	<i>18</i>	<i>60</i>
(mailing address)	<i>SAND + gravel</i>	<i>60</i>	<i>108</i>

WELL LOCATION:  
sec. *6* T *20* N R *1* E  
*1/2* miles *S* of *Shelton*  
(distance) (direction) (nearest town)

WELL PURPOSE: *IRIGATION*  
(home, irrigation, municipal, industrial)

WELL COMPLETION DATA:

(1) diameter (inches) *16"*

(2) total depth (feet) *105*

(3) static water level (feet) *25* below above top of ground.

(4) casing *Steel*, *65'*  
(material) (depth)  
*16"* if telescope see back.  
(size)

(5) screen *40*, *65'*  
(length) (depth to top)  
*16"*, *Steel*  
(size) (material)

(6) pump *80*, *1200*  
(HP) (yield gpm)  
*Quint*  
(type power)

(7) electric log *No*  
(yes or no)  
*No*  
(organization running log)

(8) how well bottom plugged  
*Steel plate*

DRILLERS REMARKS:  
*Jose*


DEPT. OF NATURAL RESOURCES  
BUREAU OF LAND & WATER  
BUREAU OF LAND & WATER RESOURCES

MAR - 3 1982

RECEIVED

If well telescopes please sketch and show depths.

GROUND LEVEL

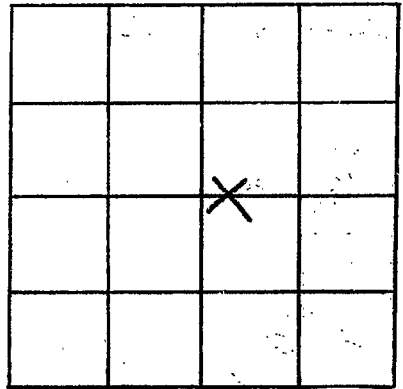

SECTION 6

Please indicate well location X.

ADDITIONAL INFORMATION

6051 / 08

If more than one screen, show locations of each on sketch.