

MISSISSIPPI DEPARTMENT OF NATURAL RESOURCES
Bureau of Land and Water Resources
 Southport Mall **CODED**
 P.O. Box 10631

Jackson, Mississippi 39209
WATER WELL DRILLERS LOG

BUTANE GAS CO. OF GREENWOOD
POST OFFICE BOX 1135
GREENWOOD, MISS. 38901 well located

Lefflore
636

3-31 1982
 date well completed

Lefflore

LANDOWNER:	description of formations encountered	from	to
<i>Gary Farms</i> (mailing address)	<i>Clay sand & gravel</i>	<i>1</i>	<i>55</i>
WELL LOCATION:			
sec. <u>6</u> T <u>20</u> N R <u>1</u> E <u>6</u> miles <u>NW</u> of <u>Greenwood</u> (distance) (direction) (nearest town)			
WELL PURPOSE: <u>Municipal</u> (home, irrigation, municipal, industrial)			
WELL COMPLETION DATA:			
(1) diameter (inches) <u>16"</u>			
(2) total depth (feet) <u>105</u>			
(3) static water level (feet) <u>20</u> <u>below</u> top of ground.			
(4) casing <u>Steel</u> , <u>65'</u> (material) (depth)			
<u>16"</u> if telescope see back. (size)			
(5) screen <u>40'</u> , <u>65'</u> (length) (depth to top)			
<u>16"</u> <u>Steel</u> (size) (material)			
(6) pump <u>50</u> <u>1200</u> (HP) (yield gpm)			
<u>Diesel</u> (type power)			
(7) electric log <u>No</u> (yes or no)			
<u>No</u> (organization running log)			
(8) how well bottom plugged <u>No</u> <u>Steel plate</u>			

DRILLERS REMARKS:
Carlos Ramos


DEPT. OF NATURAL RESOURCES
 BUREAU OF LAND & WATER RESOURCES

APR 28 1982

RECEIVED

If well telescopes please
sketch and show depths.

GROUND LEVEL

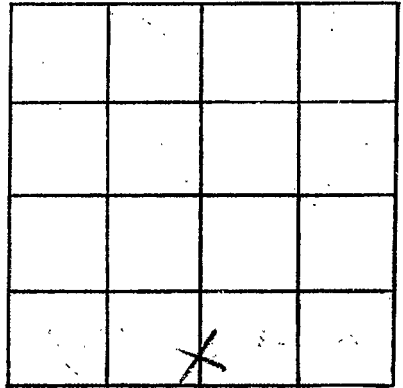

SECTION 6

Please indicate well location X.

ADDITIONAL INFORMATION

If more than one screen,
show locations of each on sketch.