

MISSISSIPPI DEPARTMENT OF NATURAL RESOURCES

Bureau of Land and Water Resources

Southport Mall

P.O. Box 10631

Jackson, Mississippi 39209 CODED

WATER WELL DRILLERS LOG

Lefflore
G 38

4-20-80 1980 Super Well Lefflore
date well completed firm name county well located

LANDOWNER: Ralph Prestige
Prestige

description of formations encountered	from	to
<u>Clay</u>	<u>0</u>	<u>18</u>
<u>Thin Sand</u>	<u>18</u>	<u>28</u>
<u>Sand</u>	<u>28</u>	<u>39</u>
<u>Sand & gravel</u>	<u>39</u>	<u>101</u>

(mailing address)

WELL LOCATION:

sec. 19 T. 20 N. R. 1 E. W
4 miles S of Schlater
(distance) (direction) (nearest town)

WELL PURPOSE:

(home, irrigation, municipal, industrial)

WELL COMPLETION DATA:

- (1) diameter (inches) 16
- (2) total depth (feet) 101
- (3) static water level (feet) 18 below above top of ground.
- (4) casing Steel 61
(material) (depth)
16 if telescope see back.
(size)
- (5) screen 40 61
(length) (depth to top)
16 Mild Steel
(size) (material)
- (6) pump 60 3000
(HP) (yield gpm)
Butane
(type power)
- (7) electric log No
(yes or no)
NONE
(organization running log)
- (8) how well bottom plugged None

DEPT. OF NATURAL RESOURCES
BUREAU OF LAND & WATER RESOURCES


MAY 14 1982

RECEIVED

DRILLERS REMARKS:

If well telescopes please sketch and show depths.

GROUND LEVEL

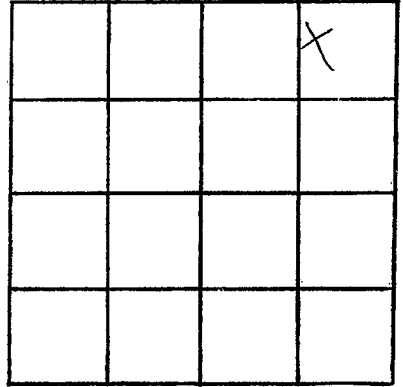

SECTION 19

Please indicate well location X.

ADDITIONAL INFORMATION

If more than one screen,
show locations of each on sketch.