

MISSISSIPPI DEPARTMENT OF NATURAL RESOURCES

Bureau of Land and Water Resources

Southport Mall

P.O. Box 10631

Jackson, Mississippi 39201

WATER WELL DRILLERS LOG

CODED

LEFLORE
G 41
2-1-84

2-1-84
date well completed

BUTANE GAS COMPANY
OF GREENWOOD

Leflore
county well located

LANDOWNER:
Brown Farms
Schlater
(mailing address)

description of formations encountered	from	to
	<u>Clay</u>	<u>0</u>
<u>sand</u>	<u>30</u>	<u>50</u>
<u>SAND & gravel</u>	<u>50</u>	<u>103</u>

WELL LOCATION:
sec. 4 T. 20 N. R. 1 E. W
1 miles S of Schlater
(distance) (direction) (nearest town)

WELL PURPOSE: Irrigation
(home, irrigation, municipal, industrial)

- WELL COMPLETION DATA:
- diameter (inches) 16"
 - total depth (feet) 103
 - static water level (feet) 33 below above top of ground.
 - casing Steel, 63,
(material) (depth)
16" if telescope see back.
(size)
 - screen 40', 63
(length) (depth to top)
16", Steel
(size) (material)
 - pump 100 1200
(HP) (yield gpm)
Diesel
(type power)
 - electric log No
(yes or no)
No
(organization running log)
 - how well bottom plugged Steel plate

DRILLERS REMARKS:
Carlos Ramos


CODED?

DEPT. OF NATURAL RESOURCES
BUREAU OF LAND & WATER RESOURCES

FEB 21 1984
RECEIVED

If well telescopes please sketch and show depths.

GROUND LEVEL

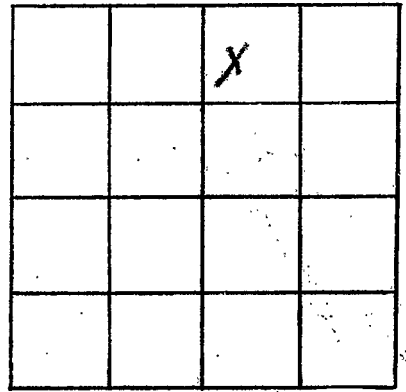

SECTION 4

Please indicate well location X.

ADDITIONAL INFORMATION

Lined area for additional information.

If more than one screen, show locations of each on sketch.