

MISSISSIPPI DEPARTMENT OF NATURAL RESOURCES

Bureau of Land and Water Resources

Southport Mall

P.O. Box 10631

CODED

Jackson, Mississippi 39209

WATER WELL DRILLERS LOG

LEFLORE
G42
2-4-84

2-4
date well completed

19 84 BUTANE GAS COMPANY
OF GREENWOOD

Leflore
county well located

LANDOWNER:
Brown Farms
Schlater M.
(mailing address)

description of formations encountered

from to

<u>Clay</u>	<u>0</u>	<u>30</u>
<u>Sand</u>	<u>30</u>	<u>50</u>
	<u>50</u>	<u>105</u>

WELL LOCATION:

sec. 5 T. 20 N. R. 1 E. W
1/4 miles SE of Schlater
(distance) (direction) (nearest town)

CODED

WELL PURPOSE: irrigation
(home, irrigation, municipal, industrial)

WELL COMPLETION DATA:

- (1) diameter (inches) 16"
- (2) total depth (feet) 105
- (3) static water level (feet) 30 below above top of ground.
- (4) casing steel 65'
(material) (depth)
16" if telescope see back.
(size)
- (5) screen 40 25'
(length) (depth to top)
16" steel
(size) (material)
- (6) pump 125 1200
(HP) (yield gpm)
Diesel
(type power)
- (7) electric log No
(yes or no)
No
(organization running log)

(8) how well bottom plugged
Steel plate

DRILLERS REMARKS:
Culer


DEPT. OF NATURAL RESOURCES
BUREAU OF LAND & WATER RESOURCES

FEB 21 1984

RECEIVED

If well telescopes please sketch and show depths.

GROUND LEVEL

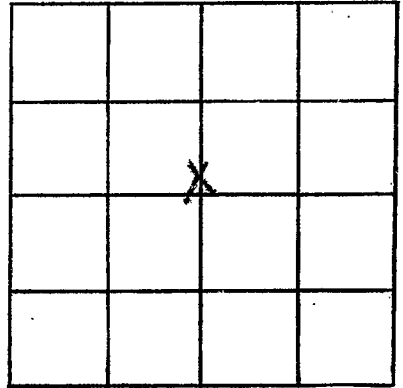

SECTION 5

Please indicate well location X.

ADDITIONAL INFORMATION

If more than one screen, show locations of each on sketch.