

MISSISSIPPI DEPARTMENT OF NATURAL RESOURCES

Bureau of Land and Water Resources

Southport Mall

P.O. Box 10631

Jackson, Mississippi 39209

WATER WELL DRILLERS LOG

CODED

LEFLORE  
G 45

BUTANE GAS COMPANY

*Leflore*

12 26 1988  
date well completed

OF GREENWOOD

county well located

LANDOWNER:	description of formations encountered	from	to
<i>Craig Rice Farm</i>  (mailing address)	<i>Clay</i>	0	12
	<i>Fine Sand</i>	12	40
	<i>Large sand</i>	40	60
	<i>Sand &amp; gravel</i>	60	85
WELL LOCATION: sec. <u>9</u> T. <u>24</u> N. R. <u>1</u> <u>2.28</u> miles <u>SE</u> of <u>Shelton</u> (distance) (direction) (nearest town)			
WELL PURPOSE: <u>EC</u> (home, irrigation, municipal, industrial)			
WELL COMPLETION DATA: (1) diameter (inches) <u>12"</u> (2) total depth (feet) <u>95'</u> (3) static water level (feet) <u>20</u> <u>below</u> above top of ground. (4) casing <u>Steel</u> , <u>55'</u> (material) (depth) <u>12"</u> if telescope see back. (size) (5) screen <u>40'</u> , <u>55'</u> (length) (depth to top) <u>12"</u> , <u>Steel</u> (size) (material) (6) pump <u>60</u> <u>900</u> (HP) (yield gpm) <u>Direct</u> (type power) (7) electric log <u>NO</u> (yes or no) <u>NO</u> (organization running log) (8) how well, bottom plugged <u>Steel plate</u>			
DRILLERS REMARKS:			

CODED


RECEIVED

JAN 08 1988

Department of Natural Resources  
Bureau of Land & Water Resources

If well telescopes please sketch and show depths.

GROUND LEVEL

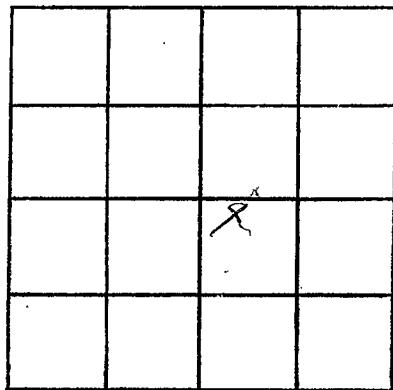

SECTION 9

Please indicate well location X.

ADDITIONAL INFORMATION

If more than one screen,  
show locations of each on sketch.