

MISSISSIPPI DEPARTMENT OF NATURAL RESOURCES

Bureau of Land and Water Resources

Southport Mall

P.O. Box 10631

Jackson, Mississippi 39209

WATER WELL DRILLERS LOG

CODED

LEFLORE
G 46

12-26

1985 BUTANE GAS COMPANY

Leflore

date well completed

OF GREENWOOD

county well located

LANDOWNER: <u>Bill Brown</u>	description of formations encountered	from	to
<u>Brown Farms</u>			
<u>Schlater</u>	<u>CLAY</u>	<u>0</u>	<u>25</u>
(mailing address)	<u>Fine SAND</u>	<u>25</u>	<u>55</u>
	<u>sand & gravel</u>	<u>55</u>	<u>95</u>

WELL LOCATION:

sec. 17 T. 24 N. R. 1 E. W
3.75 miles SE of Schlater
 (distance) (direction) (nearest town)

WELL PURPOSE:

(home, irrigation, municipal, industrial)


WELL COMPLETION DATA:

- (1) diameter (inches) 12"
- (2) total depth (feet) 95
- (3) static water level (feet) 20 below above top of ground.
- (4) casing Steel, 55'
 (material) (depth)
- 12" if telescope see back.
 (size)
- (5) screen 40' 55'
 (length) (depth to top)
- 12', steel
 (size) (material)
- (6) pump 50 700
 (HP) (yield gpm)
- Diesel
 (type power)
- (7) electric log No
 (yes or no)
- No
 (organization running log)
- (8) how well bottom plugged Steel plate

DRILLERS REMARKS:

Richard West


CODED

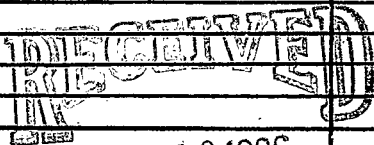

Department of Natural Resources
 Bureau of Land & Water Resources

If well telescopes please sketch and show depths.

GROUND LEVEL

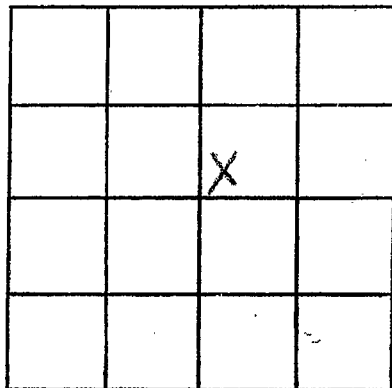

SECTION 17

Please indicate well location X.

ADDITIONAL INFORMATION

If more than one screen,
show locations of each on sketch.