

MISSISSIPPI DEPARTMENT OF NATURAL RESOURCES

Bureau of Land and Water Resources

Southport Mall

P.O. Box 10631

Jackson, Mississippi 39209

WATER WELL DRILLERS LOG

LEFLORE
G 2004
G47
GW03882

5-5-86 19 IRRIGATION EQUIPMENT LEFLORE
 date well completed firm name county well located

LANDOWNER: RAW COMPANY
INC. BOX 286
Greenwood, MS
 (mailing address)

description of formations encountered	from	to
<u>clay</u>	<u>0</u>	<u>25</u>
<u>Fine sand</u>	<u>25</u>	<u>50</u>
<u>Coarse sand/pea gravel</u>	<u>50</u>	<u>115</u>

WELL LOCATION:
 sec. 24 T 20 N R 1 E
6 miles NW of Greenwood
 (distance) (direction) (nearest town)

WELL PURPOSE: PIED
 (home, irrigation, municipal, industrial)

WELL COMPLETION DATA:

- (1) diameter (inches) 16"
- (2) total depth (feet) 115
- (3) static water level (feet) 30 below above top of ground.
- (4) casing steel 75'
 (material) (depth)
16" if telescope see back.
 (size)
- (5) screen 40' 75'
 (length) (depth to top)
16" steel
 (size) (material)
- (6) pump 110 1400
 (HP) (yield gpm)
Diesel
 (type power)
- (7) electric log NO
 (yes or no)
- (8) how well bottom plugged steel
PLATE

DRILLERS REMARKS:
#786/22 M36 D2


RECEIVED
 MAY 28 1986

Department of Natural Resources
 Bureau of Land & Water Resources

If well telescopes please sketch and show depths.

IRRIGATION EQUIPMENT
601/887-2555
INDIANOLA, MS

GROUND LEVEL

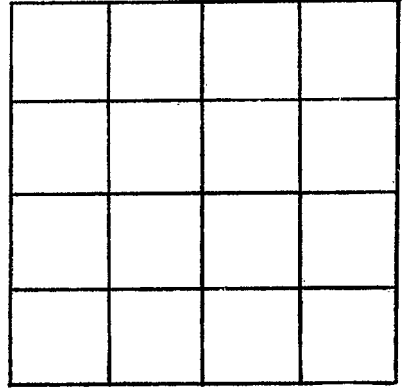

SECTION 24

Please indicate well location X.

ADDITIONAL INFORMATION

If more than one screen,
show locations of each on sketch.

MISSISSIPPI DEPARTMENT OF NATURAL RESOURCES

Bureau of Land and Water Resources

Southport Mall

P.O. Box 10631

Jackson, Mississippi 39209

WATER WELL DRILLERS LOG

CODED

47
GW03382

3382
Department of Natural Resources
Bureau of Land & Water Resources

5-5-86
date well completed

Irrigation Equipment
firm name


Letlore
county well located

LANDOWNER	description of formations encountered	from	to
<p>INC. BOX 286 GREENWOOD, MS (mailing address)</p>	<p>clay</p>	0	25
	<p>Fine sand</p>	25	50
	<p>coarse sand / pea gravel</p>	50	115
<p>WELL LOCATION: sec. <u>24</u> T. <u>20</u> N. R. <u>1</u> E. S. <u>5</u> <u>W</u></p>			
<p>_____ miles (distance) _____ miles (direction) of _____ (nearest town)</p>			
<p>WELL PURPOSE: <u>PILOT</u> (home, irrigation, municipal, industrial)</p>			
<p>WELL COMPLETION DATA:</p>			
<p>(1) diameter (inches) <u>16"</u></p>			
<p>(2) total depth (feet) <u>115</u></p>			
<p>(3) static water level (feet) _____ below / above top of ground.</p>			
<p>(4) casing <u>steel</u> <u>75'</u> (material) (depth) <u>16"</u> if telescope see back. (size)</p>			
<p>(5) screen <u>40'</u> <u>75'</u> (length) (depth to top) <u>16"</u> <u>steel</u> (size) (material)</p>			
<p>(6) pump <u>110</u> <u>1400</u> (HP) (yield gpm) <u>diesel</u> (type power)</p>			
<p>(7) electric log _____ (yes or no)</p>			
<p>_____ (organization running log)</p>			
<p>(8) how well bottom plugged <u>STEEL PLATE</u></p>			
<p>DRILLERS REMARKS: <u>Temp. Permit</u></p>			
<p><u># 86122 MSG02</u></p>			

CODED

If well telescopes please sketch and show depths.

GROUND LEVEL

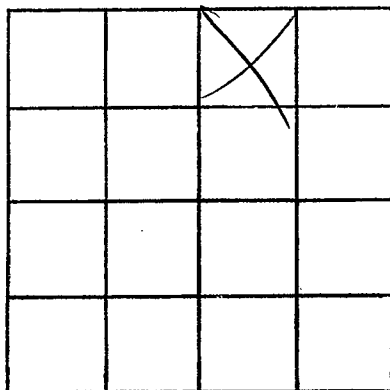

SECTION 24

Please indicate well location X.

ADDITIONAL INFORMATION

50' set 8" column

3 stays 12" turbine

If more than one screen,
show locations of each on sketch.