

# CODED

## MISSISSIPPI DEPARTMENT OF NATURAL RESOURCES

Bureau of Land and Water Resources

COUNTY WELL LOCATED	
<u>LeFlore</u>	
WELL NUMBER	CODED
<u>G 50</u>	
DATE WELL COMPLETED	
<u>6-14-88</u>	

PERMIT NUMBER	
<u>8388</u>	
NAME OF DRILLING FIRM	
<u>J L Y IRRIGATION</u>	

P.O. Box 10631  
Jackson, Mississippi 39209  
WATER WELL DRILLERS LOG

NAME & MAILING ADDRESS OF LANDOWNER			
<u>Mac Meneet</u>			
<u>Greenwood, Miss</u>			
WELL LOCATION: SEC TOWNSHIP RANGE			
<u>23 20 N 01 E</u>			
DISTANCE DIRECTION NEAREST TOWN			
<u>2 1/2</u> Miles <u>S</u> of <u>Shellman</u>			
OTHER LANDMARK			
WELL PURPOSE: Home <u>Irrigation</u> Municipal, Industrial, Fish Pond, etc.			


PUMP DATA		
PUMP TYPE (Circle One):		
Submersible, <u>Turbine</u> Jet Flowing Well,		
Other (Describe) _____		
POWER TYPE (Circle One):		
<u>Electric</u> Tractor, Diesel, Gasoline, Butane,		
Other (Describe) _____		
Pump Capacity (GPM)	No. of Stages	Setting Depth
<u>2400</u>	<u>2</u>	<u>60</u> FT.
PUMP TEST		
Well yielded <u>2400</u> GPM with		
a drawdown of <u>23</u> ft.		
after _____ hours of pumping		

WELL DATA		
Well Depth	Casing Diameter (In.)	Casing Length (Ft.)
<u>116"</u>	<u>16"</u>	<u>76</u>
Type of Casing	Hole Depth	Depth to Static Water Level
<u>Steel</u>	<u>116</u>	<u>33</u>
TYPE OF COMPLETION: (Circle One or More):		
<u>Gravel Packed</u> Underreamed, Telescoped,		
Natural Development, Open Hole, Other		
(Describe) _____		
Top of Lap Pipe or Reduction in Casing		
FEET IF TELESCOPED OR MORE THAN ONE SCREEN: USE BACK PAGE		

LOG DATA			
TYPE OF LOG RUN (Circle One):			
No Log Run, Electric, Gamma Ray, Density, Sonic, Neutron,			
Other (Describe) _____			
Name of Organization Running Log			

SCREEN DATA		
Diameter - Inches	Length - Feet	Slot Size - Inches
<u>16</u>	<u>40</u>	<u>.030</u>
Screen Type	Depth to Bottom - Feet	
<u>Steel</u>	<u>116</u>	

GEOLOGIC DATA (Office Use Only)			
Surface Elev.	Geologic Unit	Unit Thickness	Depth to Top
Subs. SWL	Date	Analysis	Aquifer Test
Driller's Remarks			

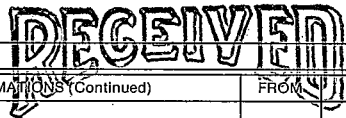

DESCRIPTION OF FORMATIONS ENCOUNTERED	FROM	TO	FORMATIONS (Continued)	FROM	TO
<u>Clay</u>	<u>0</u>	<u>17</u>			
<u>Fine Sand</u>	<u>17</u>	<u>39</u>			
<u>Sand &amp; Gravel</u>	<u>39</u>	<u>116</u>			

IF MORE SPACE IS NEEDED, USE BACK

If well telescopes please sketch and show depths.

GROUND LEVEL

			X

SECTION 23

Please indicate well location X.

ADDITIONAL INFORMATION

If more than one screen,  
show location of each on sketch.