

MISSISSIPPI DEPARTMENT OF NATURAL RESOURCES

Bureau of Land and Water Resources

P.O. Box 10631

Jackson, Mississippi 39209

WATER WELL DRILLERS LOG

128D

| | |
|-----------------------------------------|---------------------------------------------|
| COUNTY & WELL LOCATED <i>Leflore</i> | |
| WELL NUMBER <i>G 61</i> | CODE <input checked="" type="checkbox"/> |
| DATE WELL COMPLETED <i>6-10-91</i> | |

| |
|------------------------------------------|
| PERMIT NUMBER |
| NAME OF DRILLING FIRM <i>Dyn Well</i> |

| | | |
|-------------------------------------------------------------------------------|-----------|---------------------|
| NAME & MAILING ADDRESS OF LANDOWNER <i>Tacket Farms</i> | | |
| <i>Rt 1 Box 187</i> | | |
| <i>Schlater, Ms. 38952</i> | | |
| WELL LOCATION: SEC | TOWNSHIP | RANGE |
| <i>28</i> | <i>20</i> | <i>1</i> |
| DISTANCE _____ Miles _____ of _____ | | NEAREST TOWN: _____ |
| OTHER LANDMARK | | |
| WELL PURPOSE: Home <u>Irrigation</u> , Municipal, Industrial, Fish Pond, etc. | | |

| | | |
|----------------------------------------------------------------------------------------------------------------------|---------------------------|--------------------------------|
| PUMP DATA | | |
| PUMP TYPE (Circle One): Submersible, <u>Turbine</u> , Jet, Flowing Well, Other (Describe) _____ | | |
| POWER TYPE (Circle One): Electric, Tractor, <u>Diesel</u> , Gasoline, Butane, Other (Describe) _____ H/P _____ | | |
| Pump Capacity (GPM) <i>3000</i> | No. of Stages <i>1</i> | Setting Depth <i>60</i> FT. |
| PUMP TEST | | |
| Well yielded _____ GPM with a drawdown of _____ ft. after _____ hours of pumping | | |

| | | |
|---------------------------------------------------------------------------------------------------------------------------------------|-------------------------------------|-----------------------------------|
| WELL DATA | | |
| Well Depth <i>100'</i> | Casing Diameter (In.) <i>16"</i> | Casing Length (Ft.) <i>60'</i> |
| Type of Casing <i>steel</i> | Hole Depth <i>100</i> | Depth to Static Water Level |
| TYPE OF COMPLETION: (Circle One or More): <u>Gravel Packed</u> , Underreamed, Telescoped, Natural Development, Open Hole, Other | | |
| Top of Lap Pipe or Reduction in Casing | | |
| FEET <input type="checkbox"/> IF TELESCOPED OR MORE THAN ONE SCREEN: USE BACK PAGE | | |

| | |
|------------------------------------------------------------------------------------------------------------------------------|--|
| LOG DATA | |
| TYPE OF LOG RUN (Circle One): <u>No Log Run</u> , Electric, Gamma Ray, Density, Sonic, Neutron, Other (Describe) _____ | |
| Name of Organization Running Log <i>None</i> | |

| | | |
|---------------------------------|--------------------------------------|-----------------------------------|
| SCREEN DATA | | |
| Diameter - Inches <i>16"</i> | Length - Feet <i>40'</i> | Slot Size - Inches <i>.030</i> |
| Screen Type <i>Wire Wrap</i> | Depth to Bottom - Feet <i>100</i> | |

| | | | |
|---------------------------------|---------------|----------------|--------------|
| GEOLOGIC DATA (Office Use Only) | | | |
| Surface Elev. | Geologic Unit | Unit Thickness | Depth to Top |
| Subs. SWL | Date | Analysis | Aquifer Test |

| |
|-------------------|
| Driller's Remarks |
| |
| |


| DESCRIPTION OF FORMATIONS ENCOUNTERED | FROM | TO | FORMATIONS (Continued) | FROM | TO |
|---------------------------------------|-----------|------------|-----------------------------------------------------------------------------------------------------------------------------------------------------------------------------------------------------------------------|------|----|
| <i>Clay</i> | <i>0</i> | <i>25</i> | <div style="font-size: 2em; font-weight: bold; border: 2px solid black; padding: 5px; display: inline-block;">RECEIVED</div> <div style="font-size: 1.5em; font-weight: bold; margin-top: 10px;">JUL 23 1991</div> | | |
| <i>fine Sand</i> | <i>25</i> | <i>40</i> | | | |
| <i>fine Sand + gravel</i> | <i>40</i> | <i>70</i> | | | |
| <i>Sand + gravel</i> | <i>70</i> | <i>100</i> | | | |
| | | | | | |
| | | | | | |
Dept. of Environmental Quality
Bureau of Land & Water Resources

IF MORE SPACE IS NEEDED, USE BACK

If well telescopes please sketch and show depths.

GROUND LEVEL

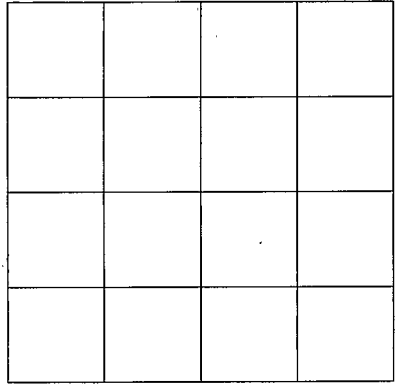

SECTION _____

Please indicate well location X.

ADDITIONAL INFORMATION

If more than one screen,
show location of each on sketch.