

MISSISSIPPI DEPARTMENT OF NATURAL RESOURCES
Bureau of Land and Water Resources

GW36803

Southport Mall
P.O. Box 10631

CODED Jackson, Mississippi 39209
WATER WELL DRILLERS LOG

G 103
Leflore Co.
3-26-84
GW36803

3/26/84 19 J & K Irrigation Leflore
date well completed firm name county well located

LANDOWNER: Barry Greenwood
(mailing address)

WELL LOCATION:
sec. 21 T. 20N. R. 1 E. S. 5 W.
9 5/8 miles SE of Schlater
(distance) (direction) (nearest town)

WELL PURPOSE: Irrigation
(home, irrigation, municipal, industrial)

- WELL COMPLETION DATA:
- (1) diameter (inches) 16
 - (2) total depth (feet) 107
 - (3) static water level (feet) 18 ^{below} _{above} top of ground.
 - (4) casing steel 67 / (material) (depth)
16 if telescope see back. (size)
 - (5) screen 40 67 / (length) (depth to top)
steel (material) (size)
 - (6) pump 80 1200 / (HP) (yield gpm)
Diesel (type power)
 - (7) electric log No / (yes or no)
(organization running log)
 - (8) how well bottom plugged plate

description of formations encountered	from	to
<u>CLAY</u>	<u>0</u>	<u>24</u>
<u>Fine SAND</u>	<u>24</u>	<u>34</u>
<u>SAND zone</u>	<u>34</u>	<u>107</u>
CODED		

DEPT. OF NATURAL RESOURCES
BUREAU OF LAND & WATER RESOURCES


APR 12 1984

RECEIVED

DRILLERS REMARKS:

If well telescopes please sketch and show depths.

GROUND LEVEL

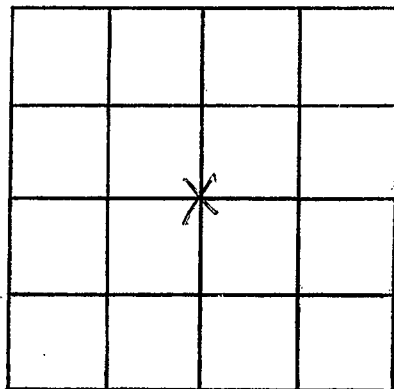

SECTION 21

Please indicate well location X.

ADDITIONAL INFORMATION

If more than one screen,
show locations of each on sketch.