

MISSISSIPPI DEPARTMENT OF NATURAL RESOURCES
Bureau of Land and Water Resources
 Southport Mall
 P.O. Box 10631
 Jackson, Mississippi 39209
WATER WELL DRILLERS LOG

G 104
 Leflore Co.
 3-28-84
 GW 3116

CODED

3/28/84 19 J&K Irrigation Leflore
 date well completed firm name county well located

LANDOWNER: Berry Greenwood

(mailing address)

WELL LOCATION:

sec. 20 T. 20 (N) R. 1 E
5 miles SE of Schlater
 (distance) (direction) (nearest town)

WELL PURPOSE: Irrigation
 (home, irrigation, municipal, industrial)

WELL COMPLETION DATA:

- (1) diameter (inches) 16
- (2) total depth (feet) 103
- (3) static water level (feet) 18 ^(below) _(above) top of ground.
- (4) casing steel 163
 (material) (depth)
16 if telescope see back.
 (size)
- (5) screen 40 163
 (length) (depth to top)
16 steel
 (size) (material)
- (6) pump 80 1200
 (HP) (yield gpm)
Diesel
 (type power)
- (7) electric log NO
 (yes or no)
 (organization running log)
- (8) how well bottom plugged plate

description of formations encountered	from	to
CLAY	0	18
FINE SAND	18	38
SAND GRAV	38	103


CODED

DRILLERS REMARKS:

DEPT. OF NATURAL RESOURCES
 BUREAU OF LAND & WATER RESOURCES
 APR 12 1984
RECEIVED

If well telescopes please sketch and show depths.

GROUND LEVEL

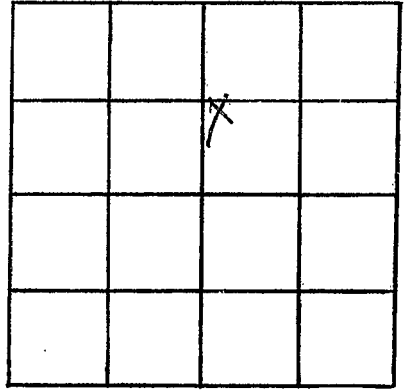

SECTION 20

Please indicate well location X.

ADDITIONAL INFORMATION

If more than one screen,
show locations of each on sketch.