

MISSISSIPPI DEPARTMENT OF NATURAL RESOURCES

Bureau of Land and Water Resources

Southport Mall

P.O. Box 10631

Jackson, Mississippi 39209

WATER WELL DRILLERS LOG

TEP
87219-DCP-01
Lefflore
G 107

Coded
128 D

87 Dyer Well Lefflore

date well completed

firm name

county well located

LANDOWNER Barry Farms

description of formations encountered

from

to

513 W-Park Avenue

CLAY

0

28

G'wood Ms 38930
(mailing address)

Fine Sand

28

47

Sand + Gravel

47

95

Fine Sand

95

98

Sand + Gravel

98

101

WELL LOCATION:

sec. 27 T. 20 N R. 1 E
3 miles N of G'wood
(distance) (direction) (nearest town)

WELL PURPOSE: Fish Ponds
(home, irrigation, municipal, industrial)

WELL COMPLETION DATA:

- (1) diameter (inches) 16"
- (2) total depth (feet) 101'
- (3) static water level (feet) _____ below above top of ground.
- (4) casing steel (material), _____ (depth),
16" (size) If telescope see back.
- (5) screen 40' (length), _____ (depth to top),
16" (size), _____ (material)
- (6) pump 60 (HP), 3000 (yield gpm)
Electric (type power)
- (7) electric log No (yes or no)
None (organization running log)
- (8) how well bottom plugged Plate

DRILLERS REMARKS:


RECEIVED

OCT 30 1987

Department of Natural Resources
Bureau of Land & Water Resources

If well telescopes please
sketch and show depths.

GROUND LEVEL

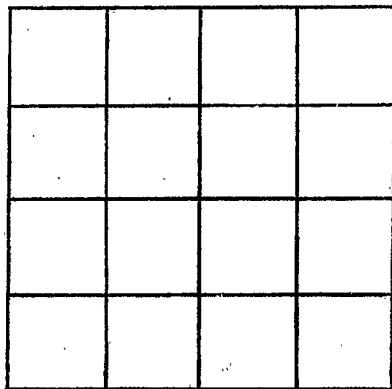

SECTION _____

Please indicate well location X.

ADDITIONAL INFORMATION

If more than one screen,
show locations of each on sketch.