

MISSISSIPPI DEPARTMENT OF NATURAL RESOURCES

Bureau of Land and Water Resources

Southport Mall

P.O. Box 10631

Jackson, Mississippi 39209

WATER WELL DRILLERS LOG

Permit Applied For LEASE

G 108
Coded

4-11-88 date well completed
Dyer Well firm name
Leflore county well located

LANDOWNER: Ann Pitman Barry
300E BARTON
D'wood Ms 38930
(mailing address)

description of formations encountered.	from	to
Clay	0	30
Thin Sand	30	60
Sand + gravel	60	105

WELL LOCATION:
128D sec. 17 T. 20 N R. 1 E
3 miles SE of Schlata
(distance) (direction) (nearest town)

WELL PURPOSE: Irrigation
(home, irrigation, municipal, industrial)

- WELL COMPLETION DATA:
- (1) diameter (inches) 12"
 - (2) total depth (feet) 105'
 - (3) static water level (feet) _____ below/above top of ground.
 - (4) casing steel (material), _____ (depth),
12" (size) if telescope see back.
 - (5) screen 40 (length), _____ (depth to top),
12" (size), _____ (material)
 - (6) pump 30 (HP), 1500 (yield gpm)
Engine (type power)
 - (7) electric log No (yes or no)
None (organization running log)
 - (8) how well bottom plugged Plate

RECEIVED


MAY 02 1988

Department of Natural Resources
Bureau of Land & Water Resources

DRILLERS REMARKS:

If well telescopes please
sketch and show depths.

GROUND LEVEL

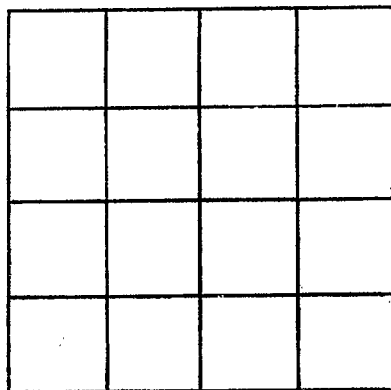

SECTION _____

Please indicate well location X.

ADDITIONAL INFORMATION

If more than one screen,
show locations of each on sketch.