· · · · · · · · · · · · · · · · · · ·	State W	ell Report	
Loflows		art 1	For Office Use Only:
County: Leflore		t of Environmental Quality	Aquifer:
Permit #: $\omega \omega 91337$	Office of Land a	nd Water Resources	Well #: 6 - 25
Irrigation Equipment		Box 10631	•
Date drilling completed: $9 - 21 - 06$		IS 39289-0631 961-5210	L. S. Elevation:
		4-6938 (fax)	E-log #:
State Law requires that this report		driller in detail and filed w	ith the Department within
30 days of completion of drilling of Well Owner Information	ion	Wel	Location
Live Oaks Plantin	ig Company	33 43 28.1	" Longitude: <u>90,34,09,4</u> <u>90,20,30</u>
Owner Name		Lantide: $\overline{33}$ $\overline{37}$ $\overline{42}$	<u>90 20 30</u>
Mailing Address: 23939 County	<u>r Road 523</u>	Method of Lat/Long (circle or	e): Conventional Survey,
		USGS quad, Hand-held	GPS, Survey-grade GPS
Schlator MC	38052	<u>SE 1/4 NW 1/4 Sec 6</u>	Twn20N Rng 1W
Schlater MS City State	ZipCode	Distance Direction	Nearest Town
662 254 7322	2.1. 0.000		of <u>Schlater</u>
Telephone No. $($			
	Well I	)ata	
Purpose of Well (circle one) Home Indus	trial Dublic Suraha	Fish Cuthur	Other
			Other:
Date well drilling started: 9-21-0	Date v	vell drilling completed:	9-21-06
If flowing, method of flow regulation: Valve	e Other (d	escribe)	
Static Water Level: <u>39</u> feet above	ve or below (circle one) la	and surface Date measured:_	9-26-06
Method of Measurement (circle one)	el tape electric tape	air line other:	
Hole depth: 136 Well depth	n: <u>136</u>	Well grouted to a depth of	10feet
Type of grout (circle one): Cement	Bentonite Mix		
	diameter: 16	_inches Type of casing:	PVC Sch.40
Screen length: <u>60</u> feet Screen	diameter: 16	inches Type of screen: P	VC Sch.40
Screen slot size: .050 inches	Setting depth: From	feet to	136 feet
Type of completion (circle all applicable):	Gravel packed Under	reamed Telescoped Open	hole Natural Development
	Other (describe):		· · · · · · · · · · · · · · · · · · ·
Top of lap pipe or reduction in casing:	feet. If tel	escoped or more than one scre	een, describe on back of page
Logs run (circle all applicable): No log run	Electric Gamma Ray	Density Sonic Neutron	Other:
Name of organization running log(s):			
I certify that the well was drilled, construct			
Department of Environmental Quality and		artment of Health regulations	and state laws.
Irrigation Equipme Patrick M. Chism	nt Inc. 0695	Patrick	M Chin'
Print Name of Water Well Contractor and Lie	cense No.	Signature of	Water Well Contractor

۴.

•

RECEIVED OCT 13 2006 BY: OLWR If well telescopes please sketch below and show depths.

## Ground Level


Description of Formations Encountered	From_	То
Clav	0	37
Clay Fine Sand/gravel Med. Sand/gravel	38	45
Med. Sand/gravel	46	133
Clay	134	136
	1	
······································		
		┠──┥
······································		
		t1

ł

r

If more than one screen, show location of each on sketch

Sketch the property layout and include the following: 1) the well location; 2) any permanent structures on the property that may aid in locating the well; 3) any roads, power lines, or other items that may aid in locating the property and the well; 4) indicate direction.

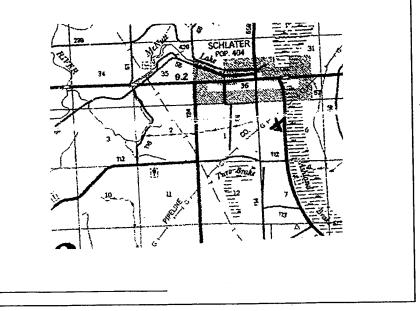

٤.,

Signature of Water Well Contractor

Landowner Name:

County:Leflore Permit #: $G W 4/339$ Irrigation Equipment Date completed: 9-21-06 Copy information from block on Part 1	F Pump Installer Mississippi Departme Office of Land P.O. Jackson, J (601)3:	ELL REPORT Part 2 's Completion Report nt of Environmental Quality and Water Resources Box 10631 MS 39289-0631 )961-5210 54-6938 (fax)	For Office Use Only: Aquifer: Well #: Elevation:	
This part of the report must be completed is report must be attached and both parts file	oy a ucenseu water well ed with the Department	at the above address within 30 d	ays of well completion.	
Well Owner Informat	ion		I Location	
Live Oaks Planting Owner Name:	Company	Latitude:	Longitude:	
Mailing Address: 23939 County Road 523		Method of Lat/Long (check one): Conventional Survey,		
		USGS quad, Hand-held	GPS, Survey-grade GPS	
Schlater MS 38952 City State ZipCode		SE W W Sec 6	τ 20N <sub>R</sub> 1W	
662-254-732		Distance Direction Nearest Town		
Telephone No. ()	······	1 Miles South	f <u>Schlater</u>	
		I		
Pump Type Circle one		Power Type Circle one		
Air Lift Jet	Submersible	Diesel Engine Gasolin	ne Engine Natural Gas	
Bucket Piston	Turbine	Electric Motor Hand	Tractor PTO	
Centrifugal Rotary	Flowing Well	Windmill Other	(specify):	
Other (specify):		Horse Power Rating of Motor	60	
Date Pump Installed: $9-26-06$		Setting Depth:		
Date Pump Installed: 9-26-06 2500-3000				
Rated Pump Capacity:	Gallons Per Minute	Number of Stages:1		
Pump Test Data		Method of Measuring Water Level		
Date Well Tested:			lircle one	
		Air Line Electric Me	asuring Line Steel Tape	
Static Water Level (A):Feet	Below Land Surface	Other (specify)		
Pumping Water Level (B):Feet 1	Below Land Surface	,,,,		
Drawdown [(B) - (A)]:Feet	Below Land Surface	For flowing well, measured s	hut in head:feet	
Test Pumping Rate:	Gallons Per Minute	Well vielded	GPM with a drawdown of	
	•			
Duration of Pump Test (minimum 4 hours):	hours	ieet after _	hours of pumping	
		A		
HEREBY CERTIFY that the above statem	ents are true to the best	of my knowledge.	a all	
Patrick M. Chism 0	695	atuck M	) (Kun	

,

0CT 13 2006 BY: OLWR