

GW03872

LEFLORE

H37

5-16-74

G150

5/16/74

MISSISSIPPI
BOARD OF WATER COMMISSIONERS
416 North State Street
Jackson, Mississippi 39201

CODED

Shelton

WATER WELL DRILLERS LOG

BUTANE GAS CO. OF GREENWOOD

Leflore

date well completed

firm name

county well located

LANDOWNER:

Latta Henry Plantation

Itta Bena, Miss.

(mailing address)

description of formations encountered

from

to

Clay

0 40

Sand & Gravel

40 103

WELL LOCATION:

sec. *31* T. *20* N

R. *1* E

4 miles *N* of *Itta Bena*

(distance) (direction) (nearest town)

WELL PURPOSE:

DR
(home, irrigation, municipal, industrial)

WELL COMPLETION DATA:

- (1) diameter (inches) *16"*
- (2) total depth (feet) *103*
- (3) static water level (feet) *13* below/above top of ground.

- (4) casing *Steel* *63*
(material) (depth)
16"
(size) if telescope see back.

- (5) screen *40'* *63*
(length) (depth to top)
16" *Steel*
(size) (material)


- (6) pump *50* *2500*
(HP) (yield gpm)
Elec.
(type power)

- (7) electric log *NO*
(yes or no)

(organization running log)

- (8) how well bottom plugged
SOIL PLATE

CODED

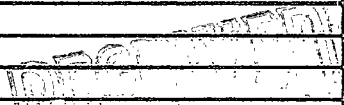

MAY 20 1974

DRILLERS REMARKS:

MIS.

If well telescopes please sketch and show depths.

GROUND LEVEL

X			

SECTION 31

Please indicate well location X.

ADDITIONAL INFORMATION

If more than one screen, show locations of each on sketch.