

MISSISSIPPI DEPARTMENT OF NATURAL RESOURCES

Bureau of Land and Water Resources

Southport Mall

P.O. Box 10631

Jackson, Mississippi 39209

CODED

WATER WELL DRILLERS LOG

Leflore  
H 103  
G 151

date well completed 6-25 1982

firm name Super Well


county well located Leflore

LANDOWNER: <u>Buddy McNear</u>	description of formations encountered	from	to
(mailing address)	<u>Clay</u>	<u>0</u>	<u>38</u>
WELL LOCATION:	<u>Sand</u>	<u>38</u>	<u>46</u>
sec. <u>16</u> T <u>20</u> N R <u>1</u> E	<u>Sand &amp; Gravel</u>	<u>46</u>	<u>103</u>
<u>1</u> miles <u>W</u> of <u>Shelburne</u>			
WELL PURPOSE: (home, irrigation, municipal, industrial)			
WELL COMPLETION DATA:			
(1) diameter (inches) <u>12</u>			
(2) total depth (feet)			
(3) static water level (feet) <u>22</u> below above top of ground.			
(4) casing <u>Steel</u> (material), (depth)			
<u>120</u> (size) if telescope see back.			
(5) screen <u>40</u> (length), (depth to top)			
<u>12</u> (size), <u>Mild Steel</u> (material)			
(6) pump <u>40</u> (HP) <u>2000</u> (yield gpm)			
<u>butane</u> (type power)			
(7) electric log <u>No</u> (yes or no)			
(organization running log)			
(8) how well bottom plugged <u>Plate</u>			
DRILLERS REMARKS:			

DEPT. OF NATURAL RESOURCES  
 BUREAU OF LAND & WATER RESOURCES  
 SEP 30 1982  
 RECEIVED

If well telescopes please sketch and show depths.

GROUND LEVEL

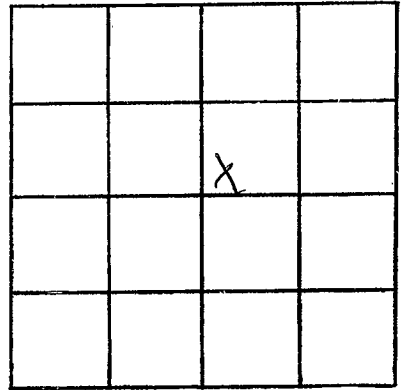

SECTION 16

Please indicate well location X.

ADDITIONAL INFORMATION

If more than one screen, show locations of each on sketch.