

Leflore
 G 100
 2-66

WATER WELL DRILLERS LOG

Butane Gas Co. of Greenwood

Date: 2/24, 1966, Driller: _____ County: Leflore

(Name)

	Description & Color of Materials Sand, Clay, Red Clay, Shell, etc.	Thick- ness Feet	Depth Feet
(1) Owner of Land: <u>Tackett & Metz</u> (Name) <u>Schlater, Miss.</u>	Clay	13	13
(Address)	"	10	23
(2) Location: <u>1/4</u> , <u>1/4</u> , Sec. <u>T R</u>	Sand & gravel	10	33
<u>7</u> miles <u>North</u> , of <u>Itta Bena</u>	" "	10	43
(distance) (direction) (Nearest Town)	" "	10	63
(3) Topography: <u>flat</u>	" "	10	73
(Hilly) (Flat) (Level)	" "	10	83
(4) Purpose of Well: <u>irrigation</u>	" "	10	93
(Domestic Irrigation Municipal, Industrial, Other)			


Information upon completion of well:

- (1) Diameter 16 inches.
- (2) Total Depth 93 feet.
- (3) Water Level 11 feet below top of ground.
- (4) Cased to 53, Size ~~16~~ 16
- (5) Screen: Size 16, Length 40'
- (6) Were any formations sealed against pollution?
 _____ yes, X no.

If YES depth of formation _____

Why _____

Drillers Remarks: _____

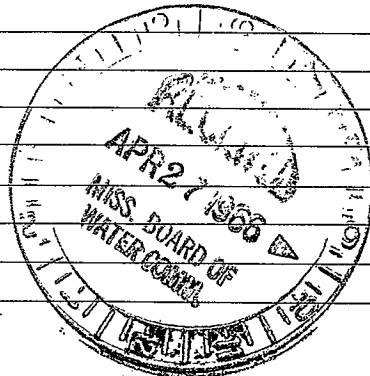

(Use Back Side)

Retain this copy for your office files.

Well No.

