

MISSISSIPPI DEPARTMENT OF NATURAL RESOURCES

Bureau of Land and Water Resources

Southport Mall

P.O. Box 10631

Jackson, Mississippi 39209

WATER WELL DRILLERS LOG

Letlore  
G WOOD  
6/10/81

6-10  
date well completed

1981 BUTANE GAS COMPANY  
OF GREENWOOD

Letlore  
county well located

LANDOWNER:	description of fomations encountered	from	to
<u>Harry Lett</u>	<u>Clay</u>	<u>0</u>	<u>35</u>
<u>Greenwood MS</u> (mailing address)	<u>Sand</u>	<u>35</u>	<u>80</u>
	<u>Gravel</u>	<u>80</u>	<u>105</u>
<b>WELL LOCATION:</b>			
sec. <u>32</u> <u>20</u> N R. <u>1</u> E			
<u>2</u> miles <u>SE.</u> of <u>Greenwood</u> (distance) (direction) (nearest town)			
<b>WELL PURPOSE:</b> <u>Domestic</u> (home, irrigation, municipal, industrial)			
<b>WELL COMPLETION DATA:</b>			
(1) diameter (inches) <u>4"</u>			
(2) total depth (feet) <u>105</u>			
(3) static water level (feet) <u>20</u> <u>below</u> above top of ground.			
(4) casing <u>PVC</u> , <u>85</u> , (material) (depth) <u>4"</u> if telescope see back. (size)			
(5) screen <u>20</u> , <u>85</u> (length) (depth to top) <u>4"</u> , <u>PVC</u> (size) (material)			
(6) pump <u>1-H</u> , <u>12</u> (HP) (yield gpm) <u>Elec.</u> (type power)			
(7) electric log (yes or no) _____			
(organization running log) _____			
(8) how well bottom plugged <u>Back well Valve</u>			
DRILLERS REMARKS: _____			


DEPT. OF NATURAL RESOURCES  
BUREAU OF LAND & WATER RESOURCES

JUN 15 1981

RECEIVED

If well telescopes please sketch and show depths.

GROUND LEVEL

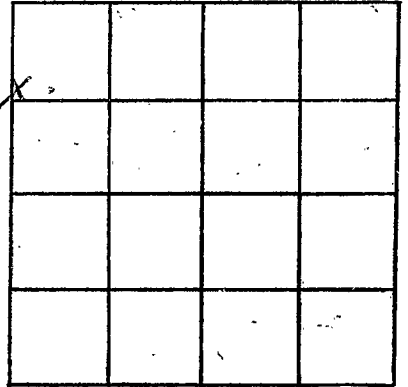

SECTION 32

Please indicate well location X.

ADDITIONAL INFORMATION

If more than one screen,  
show locations of each on sketch.