

Leflore
G 2002
1-14-77

MISSISSIPPI
BOARD OF WATER COMMISSIONERS
416 North State Street
Jackson, Mississippi 39201

15H

WATER WELL DRILLERS LOG

1-14-77 date well completed
BUTANE GAS CO. OF GREENWOOD firm name
Leflore county well located

LANDOWNER: James Pollard
Shellmound Plantation
Greenwood
(mailing address)
WELL LOCATION:
sec. 14 T. 11N R. 1 E
1 miles SW of Shellmound
(distance) (direction) (nearest town)

description of formations encountered	from	to
Clay	0	18
Sand	18	64
Sand + gravel	64	130
Rock	130	135
Sand + gravel	135	190
Clay	190	224
Clay + Sand	224	270
Sand	270	290
Shale	290	355
Rock	355	364
Shale	364	378
Rock + shale	378	384
Sand	384	405
Sand + Rock Strata	405	463
Shale	463	526
Shale + Rock	526	585
Shale + Sand	585	624
Shale	624	687
Fine sand	687	704
Shale + rock	704	724
Sandy shale	724	852
Clay	852	867
Fine sand	867	872
Shale	872	916
Fine sand	916	943
Shale	943	1016
Fine sand	1016	1036
Fine Sand + Shale	1036	1076
Shale	1076	1146
Fine sand	1146	1156
Shale + Rock	1156	1196
Sand + shale	1196	1216
Sand	1216	1235
Sand + shale	1235	1256
Sand	1256	1270

WELL PURPOSE: Home
(home, irrigation, municipal, industrial)
WELL COMPLETION DATA:
(1) diameter (inches) 4 1/2
(2) total depth (feet) 1270
(3) static water level (feet) 10 below top of ground.
(4) casing Steel 1250 (material) (depth) 4 1/2 (size) if telescope see back.
(5) screen 20 (length) 1250 (depth to top) 2" (size) Strainless (material)
(6) pump 1 (HP) 20 (yield gpm) Elec. (type power)
(7) electric log NO (yes or no)
(organization running log)
(8) how well bottom plugged Back Pressure Valve


DRILLERS REMARKS:

RECEIVED

JAN 20 1977

If well telescopes please sketch and show depths.

GROUND LEVEL

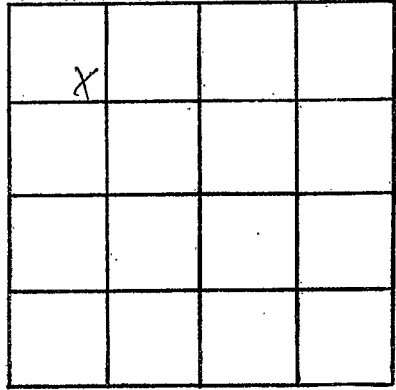

SECTION 14

Please indicate well location X.

ADDITIONAL INFORMATION

If more than one screen,
show locations of each on sketch.