

MISSISSIPPI DEPARTMENT OF ENVIRONMENTAL QUALITY

Office of Land and Water Resources

P. O. Box 10631
Jackson, MS 39289-0631

WATER WELL DRILLERS LOG

COUNTY WELL LOCATED Letflore
WELL NUMBER G-1009
DATE WELL COMPLETED 4-22-94

PERMIT NUMBER MSGW 36263
NAME OF DRILLING FIRM IRRIGATION EQUIPMENT
PHONE NUMBER 601/887-2555
CITY INDIANOLA, MS

NAME & MAILING ADDRESS OF LANDOWNER Four-Fifths Farm Inc.			
525 FAIRVIEW AVE.			
Greenville, MS 38701			
WELL LOCATION:	SEC	TOWNSHIP	RANGE
	22	20	1
		N	E
		S	W
DISTANCE	DIRECTION	NEAREST TOWN	
5 Miles	NE	of ITTA BENA	
OTHER LANDMARK			
WELL PURPOSE: Home, Irrigation, Municipal, Industrial, Fish Pond, etc. Irrigation			

PUMP DATA		
PUMP TYPE (Circle One): Submersible, Turbine , Jet, Flowing Well, Other (Describe) _____		
POWER TYPE (Circle One): Electric, Tractor, Diesel , Gasoline, Butane, Other (Describe) _____ H/P 60		
Pump Capacity (GPM)	No. of Stages	Setting Depth
2500	2	60 FT.
PUMP TEST		
Well yielded _____ GPM with a drawdown of _____ ft. after _____ hours of pumping		

WELL DATA		
Well Depth 100	Casing Diameter (in.) 16	Casing Length (Ft.) 60
Type of Casing PVC	Hole Depth 100	Depth to Static Water Level 19'

LOG DATA	
TYPE OF LOG RUN (Circle One): Electric, Gamma Ray, Density, Sonic, Neutron, Other (Describe) _____	
Name of Organization Running Log	

TYPE OF COMPLETION: (Circle One or More):
 Gravel Packed, Underreamed, Telescoped,
 Natural Development, Open Hole, Other
 (Describe) _____

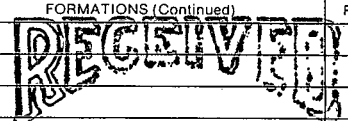
GEOLOGIC DATA (Office Use Only)			
Surface Elev.	Geologic Unit	Unit Thickness	Depth to Top
Subs. SWL	Date	Analysis	Aquifer Test

WELL GROUTED TO A DEPTH OF _____ FEET
 Type Grout (circle one): Cement, Bentonite, or Mix

SCREEN DATA		
Diameter - Inches 16	Length - Feet 40	Slot Size - Inches .030
Screen Type PVC	Depth to Bottom - Feet 100	

Driller's Remarks	
Top of Lap Pipe or Reduction in Casing	
FEET	IF TELESCOPED OR MORE THAN ONE SCREEN: USE BACK PAGE

DESCRIPTION OF FORMATIONS ENCOUNTERED	FROM	TO
clay	0	18
FINE SAND	18	35
FINE SAND + GRAVEL	35	45
MEDIUM SAND + GRAVEL	45	65
COARSE SAND + GRAVEL	65	100

FORMATIONS (Continued)		FROM	TO
			
MAY 04 1994			
Dept. of Environmental Quality Office of Land & Water Resources			
IF MORE SPACE IS NEEDED, USE BACK			

If well telescopes please sketch and show depths.

GROUND LEVEL

	X		

SECTION 22

Please indicate well location X.

ADDITIONAL INFORMATION

If more than one screen,
show location of each on sketch.