

MISSISSIPPI DEPARTMENT OF ENVIRONMENTAL

QUALITY

Office of Land and Water Resources

P. O. Box 10631

Jackson, MS 39289-0631

WATER WELL DRILLERS LOG

COUNTY WELL LOCATED
Leflore
 WELL NUMBER CODED
G 2013
 DATE WELL COMPLETED
6-11-96

PERMIT NUMBER
 NAME OF DRILLING FIRM
Irrigation Equipment
Indianola, MS 38751

NAME & MAILING ADDRESS OF LANDOWNER
Tackett Fish Farm
Rt. 1, Box 187
Schlater, MS 38952
 WELL LOCATION: SEC. TOWNSHIP RANGE
32 20N N 1W E
S W
 DISTANCE DIRECTION NEAREST TOWN
4 Miles North of Itta Bena
 OTHER LANDMARK
Fish Ponds
 WELL PURPOSE: Home, Irrigation, Municipal, Industrial, Fish Pond, etc.
Fish Ponds

PUMP DATA
 PUMP TYPE (Circle One):
 Submersible, **Turbine** Jet Flowing Well,
 Other (Describe)
 POWER TYPE (Circle One):
Electric Tractor, Diesel, Gasoline, Butane,
 Other (Describe) **60** H/P
 Pump Capacity (GPM) No. of Stages Setting Depth
3000 1 70 FT.
 PUMP TEST
 Well yielded _____ GPM with
 a drawdown of _____ ft.
 after _____ hours of pumping

WELL DATA

Well Depth 125	Casing Diameter (In.) 16	Casing Length (Ft.) 85
Type of Casing PVC	Hole Depth 125	Depth to Static Water Level 40 ft.

TYPE OF COMPLETION: (Circle One or More):
Gravel Packed, Underreamed, Telescoped,
 Natural Development, Open Hole, Other
 (Describe)

WELL GROUTED TO A DEPTH OF _____ FEET
 Type Grout (circle one): Cement, Bentonite, or Mix

SCREEN DATA

Diameter - Inches 16	Length - Feet 40	Slot Size - Inches .032
Screen Type PVC	Depth to Bottom - Feet 125	

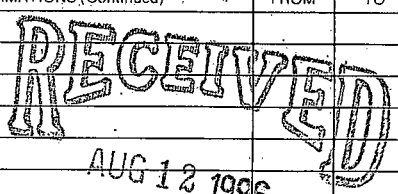
LOG DATA
 TYPE OF LOG RUN (Circle One): No Log Run,
 Electric, Gamma Ray, Density, Sonic, Neutron,
 Other (Describe)
 Name of Organization Running Log

GEOLOGIC DATA (Office Use Only)

Surface Elev.	Geologic Unit	Unit Thickness	Depth to Top
Subs. SWL	Date	Analysis	Aquifer Test

Driller's Remarks
 Top of Lap Pipe or Reduction in Casing
FEET IF TELESCOPED OR MORE THAN ONE SCREEN: USE BACK PAGE

DESCRIPTION OF FORMATIONS ENCOUNTERED	FROM	TO
Clay	0	20
Fine Sand	20	75
Fine Sand & Gravel	75	96
Med. Sand & Gravel	96	125

FORMATIONS (Continued) FROM TO

AUG 12 1996
 Dept. of Environmental Quality
 Office of Land & Water Resources
 IF MORE SPACE IS NEEDED, USE BACK

If well telescopes please
sketch and show depths.

GROUND LEVEL

	X		

SECTION 32

Please indicate well location X.

ADDITIONAL INFORMATION

If more than one screen,
show location of each on sketch.