

Leflore
 5-16-57

MISSISSIPPI BOARD OF WATER COMMISSIONERS

WATER WELL DRILLERS LOG

4/15/65
 Joe 274

Date: May 16, 19 57, Driller: Layne-Central Company Leflore

(Name)

CODED

- (1) Owner of Land: L. W. Wade
Lake Henry Plantation
Greenwood, Mississippi
 (Address) 9, 10, 11, 14 21 TW
13, 14, 5, 6 10 1F
- (2) Location: 1/4, 1/4, Sec. 31, 32, 20 R1E
5 miles north, of Itta Bena
 (distance) (direction) (Nearest Town)
- (3) Topography: flat
 (Hilly) (Flat) (Level)
- (4) Purpose of Well: irrigation
 (Domestic Irrigation, Municipal, Industrial, Other)

Description & Color of Materials Sand, Clay, Red Clay, Shell, etc.	Thick- ness Feet	Depth Feet
Clay	26	26
Clay balls & fine sand	6	32
Fine sand	13	45
Coarse sand	17	62
Sand & gravel	10	72
Sand & gravel	26	98
Sand rock	6	104
Pea gravel	8	112
Sand & gravel	3	115
Fine blue sand	2	117

Information upon completion of well:

- (1) Diameter 16x12 inches.
- (2) Total Depth 117 feet.
- (3) Water Level 20'-1" feet below top of ground.
- (4) Cased to 60', Size 16",
2' swage
- (5) Screen: Size 12", Length 50'
- (6) Were any formations sealed against pollution?
no yes, no no.

If YES depth of formation _____


Why _____

Drillers Remarks: _____

2400 GPM

engine drive

CODED

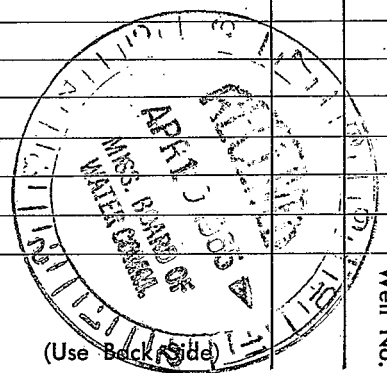

Well No.

(Use Back Side)

