

H-

1-3-57

WATER WELL DRILLERS LOG

2331

Date: Jan. 3, 1957, Driller: Layne-Central Company County Leflore

(Name)

(1) Owner of Land: L. W. Wade
(Name)

Greenwood, Mississippi
(Address)

(2) Location: 1/4, 1/4, Sec. T R

3 miles north of Greenwood
(distance) (direction) (Nearest Town)

(3) Topography: Flat
(Level)

(4) Purpose of Well: irrigation
(Domestic Irrigation, Municipal, Industrial, Other)

Information upon completion of well:

(1) Diameter: 12x10 inches.

(2) Total Depth: 112 feet.

(3) Water Level: 25' - 4" feet below top of ground.

(4) Cased to: 60', Size: 12" 2' swage

(5) Screen: Size: 10", Length: 50'

(6) Were any formations sealed against pollution?

yes, no no.

If YES depth of formation

Why


Drillers Remarks:

1000 GPM

engine drive

Description & Color of Materials Sand, Clay, Red Clay, Shell, etc.	Thick- ness Feet	Depth Feet
Clay	18	18
Fine sand & clay balls	5	23
Fine blue sand	12	35
Coarse sand	17	52
Sand & pea gravel	20	72
Sand & big gravel	20	92
Sand & gravel	20	112

CODED

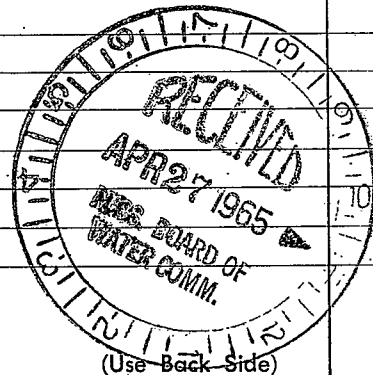

Well No.

