

Before
 H 27
 9-2-69
 M.G.S.
 9-7-69
 date well completed

MISSISSIPPI
 BOARD OF WATER COMMISSIONERS
 416 North State Street
 Jackson, Mississippi 39201

CODED

WATER WELL DRILLERS LOG

19 DELTA DRILLING CO. firm name
Letford county well located

LANDOWNER: V. W. BARROW

description of formations encountered	from	to
CLAY -	0	19
SAND & GRAVEL	19	118
CLAY & GRAVEL	118	215
SAND & CLAY	215	428
CLAY	428	515
WHITE SAND	515	575

(mailing address)

WELL LOCATION:
 sec. 20 T 30 N R 2 E
5 miles NE of GREENWOOD
 (distance) (direction) (nearest town)

WELL PURPOSE: FARM
 (home, irrigation, municipal, industrial)

WELL COMPLETION DATA:
 (1) diameter (inches) 4x3x2 1/2
 (2) total depth (feet) 575
 (3) static water level (feet) Flow below above top of ground.
 (4) casing 4 1/2 - 100' (material) (depth) 3 1/2 - 278'
4x3x2 1/2 (size) If telescope see back.
 (5) screen 20' (length) 556' (depth to top)
2 (size) STAINLESS STEEL (material)
 (6) pump NONE (HP) 55 (yield gpm)
Flows (type power)
 (7) electric log Yes (yes or no)
MISS. GEO. SURVEY (organization running log)
B.P.
 (8) how well bottom plugged NALVE

CODED

~~NOV 6 1969~~


MISS. BD. OF
 WATER COMMISSIONERS
 NOV 6 1969

MISS. BD. OF
 WATER COMMISSIONERS

DRILLERS REMARKS: LOG LOST BY DRILLER, COULD NOT FIND UNTIL NOV. 11-3-69

If well telescopes please sketch and show depths.

GROUND LEVEL

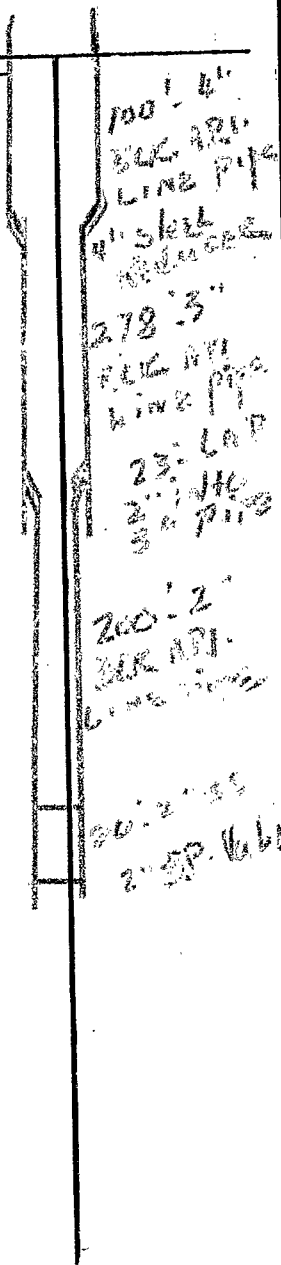

SECTION 20

Please indicate well location X.

ADDITIONAL INFORMATION

WELL FEELS 33 GPM
 WITH 6" 100' W. PUMP
 1/4" PUMPING W/ 1/2
 H. 2" SHALLOW W/ P
 Pump

If more than one screen, show locations of each on sketch.