

WATER WELL

Leflore
H-29

Date: JUNE, 1964, Driller: DELTA DRILLING Co. County LEFLORE

6-64

3603 430

(Name)

(1) Owner of Land: A.G. HAVENS
(Name)

CRAIGSIDE, MISS
(Address)

(2) Location: 1/4, 1/4, Sec. 20 T12R2E,
_____ miles _____ of _____
(distance) (direction) (Nearest Town)

(3) Topography: _____
(Hilly) (Flat) (Level)

(4) Purpose of Well: DOMESTIC -
(Domestic Irrigation
Municipal, Industrial, Other)

Description & Color of Materials Sand, Clay, Red Clay, Shale, etc.	Thickness Feet	Depth Feet
<u>SAND</u>	<u>9</u>	<u>85</u>
<u>GRAVEL</u>	<u>9</u>	<u>94</u>
<u>GUMBO</u>	<u>36</u>	<u>130</u>
<u>SHALE</u>	<u>23</u>	<u>153</u>
<u>GUMBO</u>	<u>64</u>	<u>217</u>
<u>SHALE W/ROCKS</u>	<u>65</u>	<u>282</u>
<u>SAND W/ROCKS</u>	<u>54</u>	<u>336</u>

CODED

Information upon completion of well:

(1) Diameter 2 inches.

(2) Total Depth 336 feet.

(3) Water Level _____ feet below top of ground.

(4) Cased to 315, Size 2"

(5) Screen: Size 2" Length 21'
PERFORATED PIPE

(6) Were any formations sealed against pollution?
_____ yes, _____ no.

If YES depth of formation _____


Why _____

Drillers Remarks: 1/2 H.P. RED JACKET

PUMP SET IN WELL - W/

1/2 GAL VALV TANK

CODED

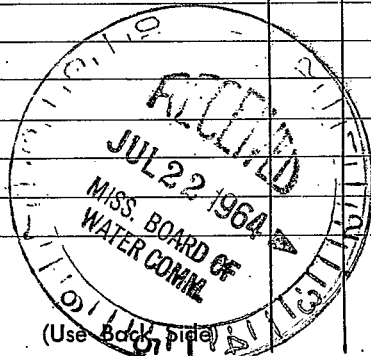

Well No. _____

6300

6300