

Leflore
H-30
1-2-57

MISSISSIPPI BOARD OF WATER COMMISSIONERS

WATER WELL DRILLERS LOG

c 331

Date: Jan. 2, 19 57, Driller: Layne-Central Company County Leflore

GS schedule pays Section 32 T^{Name} 20 N R 1 E

(1) Owner of Land: L. W. Wade
(Name)
Greenwood, Mississippi
(Address) 9, 10, 11, 14, 15, 16 21 1W
5, 6 19 1E

(2) Location: 1/4, 1/4, Sec. 31, 32 T20 R1E,
2 miles north of Greenwood
(distance) (direction) (Nearest Town)

(3) Topography: flat
(Hilly) (Flat) (Level)

(4) Purpose of Well: irrigation
(Domestic Irrigation
Municipal, Industrial, Other)

Description & Color of Soil Sand, Clay, Red Clay, Silt	Thick- ness Feet	Depth Feet
Clay	23	23
Clay & coarse sand	9	32
Coarse sand & pea gravel	20	52
Sand & pea gravel	26	78
Rock	2	80
Sand & gravel	31	111
Clay	1	112

CODED

Information upon completion of well:

(1) Diameter 12x10 inches.

(2) Total Depth 112 feet.

(3) Water Level 24' - 4" feet below top of ground.

(4) Cased to 60', Size 12"
2' swage

(5) Screen: Size 10", Length 50'


(6) Were any formations sealed against pollution?
no yes, no no.

CODED

If YES depth of formation _____

Why _____

Drillers Remarks: _____
1000 GPM
engine drive

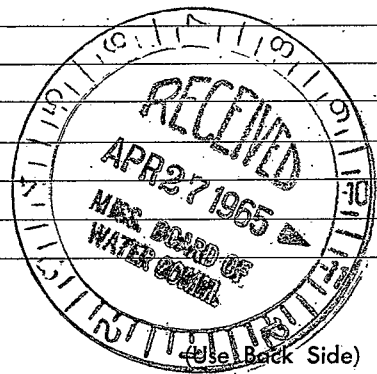

Well No.

