

before

MISSISSIPPI BOARD OF WATER COMMISSIONERS

QH-31

5-16-57

WATER WELL DRILLERS LOG

4/15/63
274

Date: May 16, 1957, Driller: Layne-Central Company County Leflore

OS Schedule says Section 15 (Name) T20N R1E

- (1) Owner of Land: L. W. Wade
Lake Henry Plantation
Greenwood, Mississippi
(Address)
- (2) Location: 1/4, 1/4, Sec. T R ,
5 miles north, of Itta Bena,
(distance) (direction) (Nearest Town)
- (3) Topography: flat
(Hilly) (Flat) (Level)
- (4) Purpose of Well: irrigation
(Domestic Irrigation
Municipal, Industrial, Other)

CODED

Description & Color of Materials Sand, Clay, Red Clay, Shell, etc.	Thick- ness Feet	Depth Feet
Clay	24	24
Clay balls & fine sand	8	32
Fine sand	11	43
Coarse sand & gravel	29	72
Coarse sand & gravel	18	90
Clay balls & coarse sand	2	92
Sand & gravel	10	112
Sand & gravel	3	115
Clay	2	117

Information upon completion of well:

- (1) Diameter 16x12 inches.
- (2) Total Depth: 117 feet.
- (3) Water Level 23'-6" feet below top of ground.
- (4) Cased to 63', Size 16",
2' swage
- (5) Screen: Size 12", Length 50'
- (6) Were any formations sealed against pollution?
 yes, no no.

CODED


If YES depth of formation

Why

Drillers Remarks:

2400 GPM

engine drive

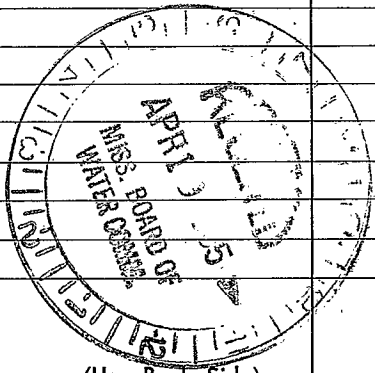

(Use Back Side)

Well No.

[The page contains extremely faint and illegible text, likely bleed-through from the reverse side of the document. The text is scattered across the page and cannot be transcribed accurately.]