

LEFLORE
H 32
6-2-71

MISSISSIPPI
 BOARD OF WATER COMMISSIONERS
 416 North State Street
 Jackson, Mississippi 39201

CODED

LEFLORE

WATER WELL DRILLERS LOG

DYER WELL & IRRIGATION SERVICE

6/2/71

6/2/71 19
 date well completed

firm name

county well located

LANDOWNER:

Cambo Hunting Club

description of formations encountered

from

to

GREENWOOD MISS.
 (mailing address)

CLAY	0	22
SAND	22	62
SAND & GRAVEL	62	142
CLAY	142	222
ROCK	222	224
SAND & CLAY	224	262
SAND GREEN	262	282
CLAY	282	290
SAND GREEN	290	382

WELL LOCATION:

sec 22 T 20 N R 1 E
 S W
3 miles N of G-WOOD
 (distance) (direction) (nearest town)

WELL PURPOSE: CLAY HOUSE
 (home, irrigation, municipal, industrial)

WELL COMPLETION DATA:

- (1) diameter (inches) 2"
- (2) total depth (feet) 382'
- (3) static water level (feet) 0 below above top of ground.
- (4) casing CAD PIPE 372'
 (material) (depth)
2"
 (size) if telescope see back.
- (5) screen 10' 372'
 (length) (depth to top)
2" STAINLESS STEEL
 (size) (material)
- (6) pump 1/2 8
 (HP) (yield gpm)
ELEC.
 (type power)
- (7) electric log N/A
 (yes or no)

CODED

(organization running log)

(8) how well bottom plugged B.P.U.


061 26 1971

DRILLERS REMARKS:

Miss. Div. of
 WATER CONTROL

If well telescopes please sketch and show depths.

GROUND LEVEL

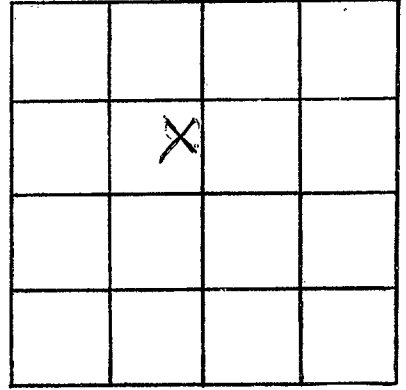

SECTION 22

Please indicate well location X.

ADDITIONAL INFORMATION

If more than one screen, show locations of each on sketch.