

LEFLORE

H 39

7-25-74

MISSISSIPPI BOARD OF WATER COMMISSIONERS
416 North State Street
Jackson, Mississippi 39201

CODED

WATER WELL DRILLERS LOG

BUTANE GAS CO. OF GREENWOOD

Leflore

7-25-74 19
date well completed

firm name

county well located

LANDOWNER:

Little Zion Church

Greenwood
(mailing address)

description of formations encountered

from

to

Clay
Sand

0 18
18 86

WELL LOCATION:

sec. 24 T. 20 N R. 1 E
S CW
2 miles N of Greenwood
(distance) (direction) (nearest town)

WELL PURPOSE:

(home, irrigation, municipal, industrial)

WELL COMPLETION DATA:

- (1) diameter (inches) 2"
- (2) total depth (feet) 70
- (3) static water level (feet) 16 below top of ground.
- (4) casing PVC, 60 (material), (depth), 2" (size) if telescope see back.
- (5) screen 10 (length), 60 (depth to top), 2" (size), PVC (material)
- (6) pump 1/3 (HP), 5 (yield gpm), Elec (type power)
- (7) electric log No (yes or no)

CODED

(organization running log)

(8) how well bottom plugged
Back Pressure Valve

DRILLERS REMARKS:


RECEIVED

AUG - 8 1974

MISS. RD. OF WATER COMM.

If well telescopes please sketch and show depths.

GROUND LEVEL

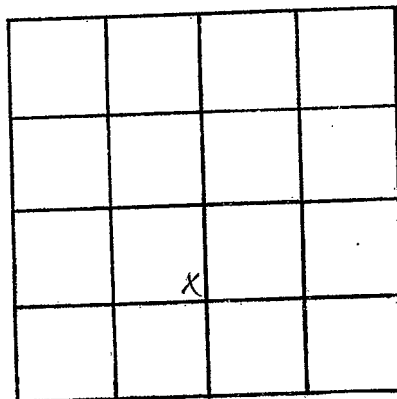

SECTION 29

Please indicate well location X.

ADDITIONAL INFORMATION

If more than one screen, show locations of each on sketch.