

LEFLORE
H 40
8-19-74

MISSISSIPPI
 BOARD OF WATER COMMISSIONERS
 416 North State Street
 Jackson, Mississippi 39201

CODED

WATER WELL DRILLERS LOG

8-19-74 19 Benton County of Mendocino Leflore
 date well completed firm name county well located

LANDOWNER:
D. H. Goss
Greenwood
 (mailing address)

description of formations encountered	from	to
Clay	0	41
SAND	41	150
SHALE	150	181
SHALE	181	373
Sandy SHALE	373	398
HARD SHALE	398	404
SANDY SHALE	404	434
HARD SHALE	434	570
Green Sand	570	610

WELL LOCATION:
 sec. 31 T 20 (N) R. 2 E
 & (W)
3 miles NE of Greenwood
 (distance) (direction) (nearest town)

WELL PURPOSE: Home
 (home, irrigation, municipal, industrial)

WELL COMPLETION DATA:

(1) diameter (inches) 2

(2) total depth (feet) 608

(3) static water level (feet) 15 below above top of ground.

(4) casing Steel 588
 (material) (depth)
2" If telescope see back.
 (size)

(5) screen 20' 588
 (length) (depth to top)
2" STAINLESS
 (size) (material)

(6) pump 1/2 10
 (HP) (yield gpm)
Elec.
 (type power)

(7) electric log NO
 (yes or no)
 (organization running log)

(8) how well bottom plugged
LEAD PUG

CODED


RECEIVED
 SEP - 3 1974

MISS. BD. OF WATER COMMISSIONERS

DRILLERS REMARKS:

If well telescopes please sketch and show depths.

GROUND LEVEL

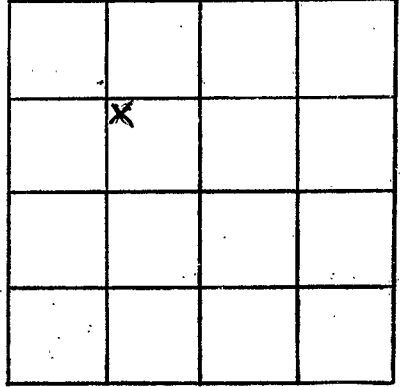

SECTION 31

Please indicate well location X.

ADDITIONAL INFORMATION

If more than one screen,
show locations of each on sketch.