

LeFlore  
H 75  
1-67

MISSISSIPPI  
BOARD OF WATER COMMISSIONERS  
416 North State Street  
Jackson, Mississippi 39201

CODED

WATER WELL DRILLERS LOG

1-26-67 19 Bullock Gas Co. of Greenwood LeFlore  
date well completed firm name county well located

LANDOWNER: T. J. GARY  
Wildwood Plantation  
Greenwood, Miss.  
(mailing address)

description of formations encountered	from	to
CLAY	0	18
SAND + GRAVEL	18	125
SAND + CLAY	125	290
CLAY	290	360
SHALE	360	600
CLAY	600	640
SAND + CLAY	640	680
WHITE SAND	680	723


WELL LOCATION:  
sec. 6 T. 20 N. R. 1 E  
SW NE  
2 miles SW of MOONEY  
(distance) (direction) (nearest town)

WELL PURPOSE: Home  
(home, irrigation, municipal, industrial)

WELL COMPLETION DATA:

- (1) diameter (inches) 4 3/4
- (2) total depth (feet) 723
- (3) static water level (feet) 10 below above top of ground.
- (4) casing Steel, 693  
(material) (depth)  
4 x 2 1/2 if telescope see back.  
(size)
- (5) screen 30, 693  
(length) (depth to top)  
2", Stainless Steel  
(size) (material)
- (6) pump 2, 45  
(HP) (yield gpm)  
Elec.  
(type power)
- (7) electric log NO  
(yes or no)  
(organization running log)
- (8) how well bottom plugged BRASS  
Back Wash Valve

CODED

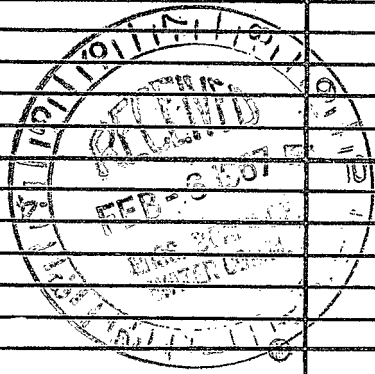

DRILLERS REMARKS:

