

**MISSISSIPPI
BOARD OF WATER COMMISSIONERS**
416 North State Street
Jackson, Mississippi 39201

WATER WELL DRILLERS

CODED

LEFLORE
H 76
3-68

3-8-68
date well completed

Butane Gas Co. of Greenwood
firm name

Leflore
county well located

LANDOWNER:

Howard Planting Co.

Greenwood, Miss.
(mailing address)

description of formations encountered

from to

CLAY	0	20
SAND	20	60
SAND + GRAVEL	60	100

WELL LOCATION:

sec. 34 T 20 N R 1 E

1/4 miles NE of Greenwood
(distance) (direction) (nearest town)

WELL PURPOSE: Home
(home, irrigation, municipal, industrial)

WELL COMPLETION DATA:


- (1) diameter (inches) 2
- (2) total depth (feet) 100
- (3) static water level (feet) 18' below top of ground.
- (4) casing Steel, 84'
(material) (depth)
2 if telescope see back.
(size)
- (5) screen 10', 84'
(length) (depth to top)
2", PVC
(size) (material)
- (6) pump 3/4, 5
(HP) (yield gpm)
Elec.
(type power)
- (7) electric log NO
(yes or no)

CODED

(organization running log)


(8) how well bottom plugged
BASIC WASH VALVE

DRILLERS REMARKS:

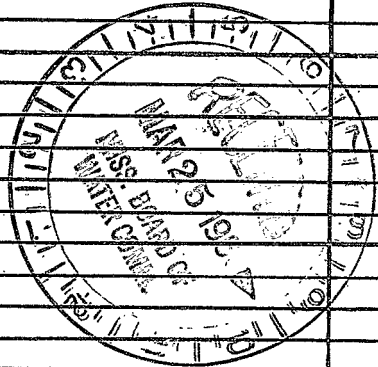

If well telescopes please sketch and show depths.

GROUND LEVEL

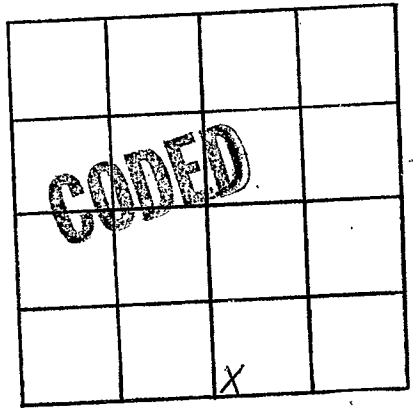

SECTION 34

Please indicate well location X.

ADDITIONAL INFORMATION

If more than one screen, show locations of each on sketch.