

LEFLORE  
H77  
4-15-76  
Flog # 99

MISSISSIPPI  
BOARD OF WATER COMMISSIONERS  
416 North State Street  
Jackson, Mississippi 39201  
WATER WELL DRILLERS LOG

CODED

4-15-76 19 BUTANE GAS CO. OF GREENWOOD Le Flore  
date well completed firm name county well located

LANDOWNER:	description of formations encountered	from	to
DOROTHY BERWALDER Money (mailing address)			
	Sand	20	40
	Sand + Per Gravel	40	90
	Gravel	90	130
	Clay	130	150
	Sand + Gravel	150	200
	SANDY CLAY	200	280
	SILT	280	300
	Clay + Silts	300	520
	Sand	520	550
	Clay + Silts - streaks	550	1386
WELL LOCATION: sec. 5 T 20 N R 1 E 1 miles S of Money (distance) (direction) (nearest town)			
WELL PURPOSE: Home (home, irrigation, municipal, industrial)			
WELL COMPLETION DATA: (1) diameter (inches) 4 x 2 (2) total depth (feet) 545 (3) static water level (feet) 1 below top of ground. (4) casing Steel 525 (material) (depth) 4 x 2 (size) If telescope see back. (5) screen 20' 525 (length) (depth to top) 2" stainless (size) (material) (6) pump 3/4 10 (HP) (yield gpm) Elec. (type power) (7) electric log yes (yes or no) MGS (organization running log) (8) how well bottom plugged Lead Plug			
DRILLERS REMARKS:			

CODED

RECEIVED  
APR 20 1976

MISS. DD. OF WATER


If well telescopes please sketch and show depths.

GROUND LEVEL

105' - 4" CASING →

420' - 2" CASING →

20' - 2" Screen →

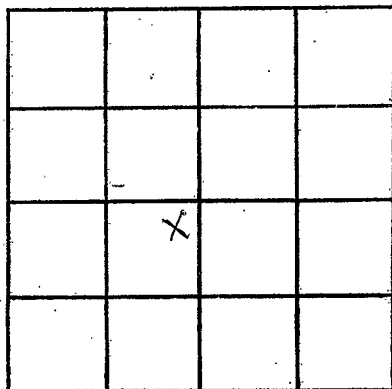

SECTION 5

Please indicate well location X.

ADDITIONAL INFORMATION

If more than one screen, show locations of each on sketch.