

LEFLORE
H 79
7-5-79

MISSISSIPPI
BOARD OF WATER COMMISSIONERS
416 North State Street
Jackson, Mississippi 39201

WATER WELL DRILLERS LOG

7-5 1979 Griner Drilling Leflore
date well completed firm name county well located

LANDOWNER:
Par-co Drilling Co
P.O. Box 8730
Natchez, Ms
(mailing address)

description of formations encountered	from	to
chalk	0	42
streaked gravel	42	105
chalk	105	189
chalk + sand	189	210
chalk + rock	210	273
sand	273	315

WELL LOCATION: 1980' N4 66°01'E
sec. 5 T. 20N R. 2E of
Greenwood
(distance) (direction) (nearest town)

WELL PURPOSE: oil field supply
(home, irrigation, municipal, industrial)

- WELL COMPLETION DATA:
- (1) diameter (inches) 3"
 - (2) total depth (feet) 315'
 - (3) static water level (feet) 70' below top of ground.
 - (4) casing steel 315' (material) (depth)
3" (size) if telescope see back.
 - (5) screen 42' 273' (length) (depth to top)
3" perforated (size) (material)
 - (6) pump AC 65 (HP) (yield gpm)
(type power)
 - (7) electric log (yes or no)
- (organization running log)

(8) how well bottom plugged
orange ped

DRILLERS REMARKS:


Miss. Board of Water Comm.

AUG 20 1979

RECEIVED

If well telescopes please sketch and show depths.

GROUND LEVEL

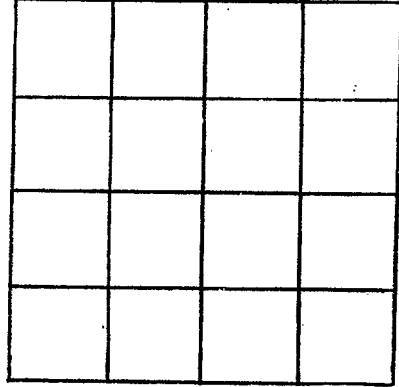

SECTION _____

Please indicate well location X.

ADDITIONAL INFORMATION

If more than one screen, show locations of each on sketch.