

LEFLORE
H80
9/79
E log #103

MISSISSIPPI
BOARD OF WATER COMMISSIONERS
416 North State Street
Jackson, Mississippi 39201

CODED

WATER WELL DRILLERS LOG


Sept 19 79 Delta Drilling Co. before
date well completed firm name county well located

LANDOWNER: <u>Ralph Guy Smith</u>	description of formations encountered	from	to
<u>Greenwood, Ms 38930</u> (mailing address)			
WELL LOCATION: sec. <u>34</u> T. <u>20</u> N R. <u>1</u> E	Gumbo	0	9
(distance) miles _____ of _____ (direction) of _____ (nearest town)	SAND	9	115
WELL PURPOSE: (home) Irrigation, municipal, industrial	SAND + CLAY	115	145
WELL COMPLETION DATA:	SAND	145	170
(1) diameter (inches) <u>4" x 2 1/2"</u>	SHALE	170	271
(2) total depth (feet) <u>675</u>	SAND	271	321
(3) static water level (feet) _____ below above top of ground.	SHALE	321	309
(4) casing _____ (material) _____ (depth)	SAND	409	441
_____ (size) If telescope see back.	SHALE	441	502
(5) screen <u>21</u> _____ (length) _____ (depth to top)	SAND BRANDED	502	580
<u>2 1/2</u> _____ (size) _____ (material)	GREEN SAND CODED	580	635
(6) pump _____ (HP) _____ (yield gpm)	SHALE	635	645
(type power)			
(7) electric log <u>YES</u> (yes or no)			
(organization running log)			
(8) how well bottom plugged <u>BACK PRESSURE VALVE</u>			
DRILLERS REMARKS:			

REC'D - 9-28-79
DAN

If well telescopes please sketch and show depths.

GROUND LEVEL

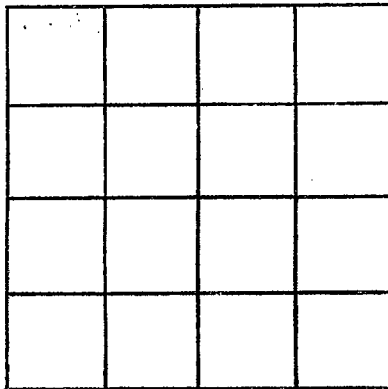

SECTION _____

Please indicate well location X.

ADDITIONAL INFORMATION

Multiple horizontal lines for providing additional information.

If more than one screen, show locations of each on sketch.

