

Leflore
 0 H81
 6-13-80

MISSISSIPPI
 BOARD OF WATER COMMISSIONERS
 416 North State Street
 Jackson, Mississippi 39201

CODED

WATER WELL DRILLERS LOG

6/13 19 80 *Dyer* *Leflore*
 date well completed firm name county well located

LANDOWNER:	description of formations encountered	from	to
<i>HERMAN GOODWIN JR</i>	<i>Clay & sand</i>	0	23
<i>McCain, Arkansas</i> (mailing address)	<i>sil. sand</i>	23	53
	<i>sand gravel</i>	33	43
	<i>sand gravel</i>	43	53
	<i>sand gravel</i>	53	63
	<i>Gravel</i>	63	73
	<i>sand gravel</i>	73	83
	<i>Gravel</i>	83	93
	<i>Gravel</i>	93	103
	<i>Gravel</i>	103	112

WELL LOCATION:

sec. 3 T. 70 N R. 10 E
 S W
3 miles SE of Money
 (distance) (direction) (nearest town)


WELL PURPOSE: Domestic
 (home, irrigation, municipal, industrial)

WELL COMPLETION DATA:

- diameter (inches) 16"
- total depth (feet) 113'
- static water level (feet) 20' below top of ground.
- casing Steel, 113'
 (material) (depth)
16" if telescope see back.
 (size)
- screen 40', 73'
 (length) (depth to top)
16", Steel
 (size) (material)
- pump 60, 3000
 (HP) (yield gpm)
Diesel
 (type power)
- electric log
 (yes or no)

 (organization running log)
- how well bottom plugged plate


CODED

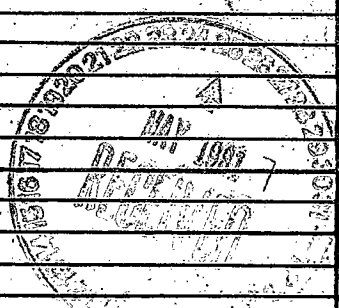

DRILLERS REMARKS:

If well telescopes please sketch and show depths.

GROUND LEVEL

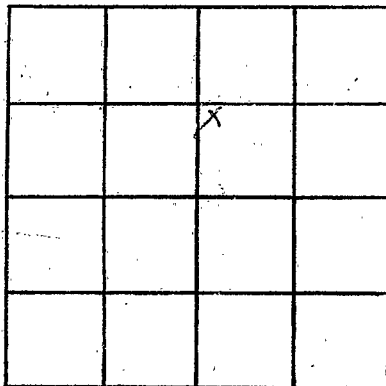

SECTION 3

Please indicate well location X.

ADDITIONAL INFORMATION

If more than one screen, show locations of each on sketch.