

LEFLORE  
H 96  
10/16/80

MISSISSIPPI  
BOARD OF WATER COMMISSIONERS  
416 North State Street  
Jackson, Mississippi 39201

CODED

WATER WELL DRILLERS LOG

10-16 1980 BUTANE GAS COMPANY - LEFLORE -  
date well completed OF GREENWOOD name county well located

LANDOWNER: JERRY MORRIS  
McCROPY, ARKANSAS  
(mailing address)

description of formations encountered	from	to
Clay	0	24
FINE SAND	24	30
SANDY PEA GRAVEL	30	50
SAND	50	70
SANDY GRAVEL	70	100

WELL LOCATION:  
sec. 15 T 20 N R 10 E  
4 miles North of GREENWOOD  
(distance) (direction) (nearest town)

WELL PURPOSE: IRRIGATION  
(home, irrigation, municipal, industrial)

CODED

- WELL COMPLETION DATA:
- (1) diameter (inches) 16"
  - (2) total depth (feet) 100'
  - (3) static water level (feet) 20 below top of ground.
  - (4) casing STEEL 60'  
(material) (depth)
  - (size) If telescope see back.
  - (5) screen 40' 60'  
(length) (depth to top)
  - 16" STEEL  
(size) (material)
  - (6) pump 60 2500  
(HP) (yield gpm)
  - DIESEL  
(type power)
  - (7) electric log No  
(yes or no)
  - No  
(organization running log)
  - (8) how well bottom plugged  
STEEL PLATE

DEPT. OF NATURAL RESOURCES  
BUREAU OF LAND & WATER RESOURCES


OCT 21 1980

RECEIVED

DRILLERS REMARKS:

If well telescopes please sketch and show depths.

GROUND LEVEL

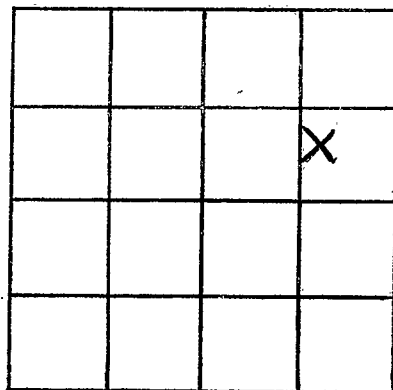

SECTION 15

Please indicate well location X.

ADDITIONAL INFORMATION

If more than one screen, show locations of each on sketch.