

LeFlore  
H 97  
10/14/80

MISSISSIPPI  
BOARD OF WATER COMMISSIONERS  
416 North State Street  
Jackson, Mississippi 39201

WATER WELL DRILLERS LOG  
BUTANE GAS COMPANY  
OF GREENWOOD

LEFLORE  
county well located

Oct 14 1980  
date well completed

LANDOWNER: JERRY MORRIS  
McCreary, Arkansas  
(mailing address)

description of formations encountered	from	to
Clay	0	26
FINE SAND	26	40
SAND & GRAVEL	40	100

WELL LOCATION:  
sec. 15 T 20N R 1E  
4 miles North of GREENWOOD  
(distance) (direction) (nearest town)

WELL PURPOSE: IRRIGATION  
(home, irrigation, municipal, industrial)

- WELL COMPLETION DATA:
- (1) diameter (inches) 16"
  - (2) total depth (feet) 100
  - (3) static water level (feet) 20 below above top of ground.
  - (4) casing STEEL, 60'  
(material) (depth)  
(size) if telescope see back.
  - (5) screen 40', 60'  
(length) (depth to top)  
16", STEEL  
(size) (material)
  - (6) pump 60 3500  
(HP) (yield gpm)  
DIESEL  
(type power)
  - (7) electric log No  
(yes or no)  
No  
(organization running log)
  - (8) how well bottom plugged  
STEEL PLATE

DEPT. OF NATURAL RESOURCES  
BUREAU OF LAND & WATER RESOURCES


OCT 21 1980

RECEIVED

DRILLERS REMARKS:

If well telescopes please sketch and show depths.

GROUND LEVEL

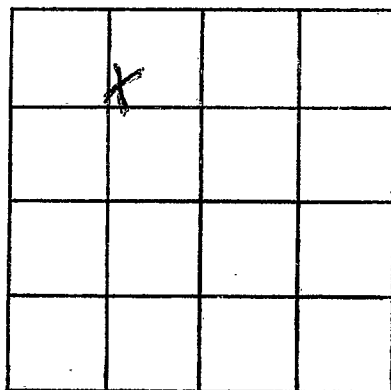

SECTION 15

Please indicate well location X.

ADDITIONAL INFORMATION

If more than one screen, show locations of each on sketch.