

Leflore
H 98
10/15/80

GW12266

MISSISSIPPI
BOARD OF WATER COMMISSIONERS
416 North State Street
Jackson, Mississippi 39201

CODED

WATER WELL DRILLERS LOG

Oct 15

date well completed

1980 **PROPANE GAS COMPANY**
OF GREENWOOD

LEFLORE
county well located

LANDOWNER: <u>Jerry Morris</u>	description of fomations encountered	from	to
<u>McCreary Arkansas</u>			
	<u>SAND & PER GRAVEL</u>	<u>27</u>	<u>50</u>
	<u>SAND & GRAVEL</u>	<u>50</u>	<u>100</u>

(mailing address)

WELL LOCATION:
sec. 15 T. 20 N R. 1 E
S
4 miles North of GREENWOOD
(distance) (direction) (nearest town)

CODED

WELL PURPOSE: IRRIGATION
(home, irrigation, municipal, industrial)

WELL COMPLETION DATA:

- (1) diameter (inches) 16"
- (2) total depth (feet) 100
- (3) static water level (feet) 20 below above top of ground.
- (4) casing STEEL, 100'
(material) (depth)
(size) If telescope see back.
- (5) screen 40', 60'
(length) (depth to top)
16", STEEL
(size) (material)
- (6) pump 60 2500
(HP) (yield gpm)
DIESEL
(type power)
- (7) electric log No
(yes or no)
No
(organization running log)
- (8) how well bottom plugged STEEL PLATE

DEPT. OF NATURAL RESOURCES
BUREAU OF LAND & WATER RESOURCES

OCT 21 1980


RECEIVED

DRILLERS REMARKS:

[Handwritten signature]

If well telescopes please sketch and show depths.

GROUND LEVEL

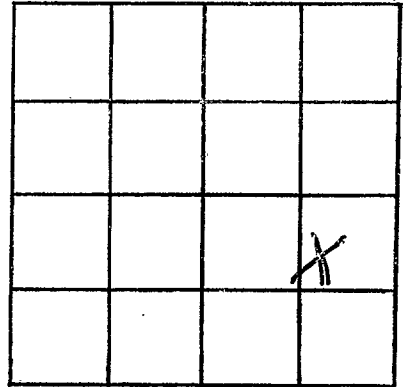

SECTION 15

Please indicate well location X.

ADDITIONAL INFORMATION

If more than one screen,
show locations of each on sketch.