

MISSISSIPPI DEPARTMENT OF NATURAL RESOURCES
Bureau of Land and Water Resources
 Southport Mall
 P.O. Box 10631
 Jackson, Mississippi 39209
WATER WELL DRILLERS LOG

CODED

Leflore
H 99

5-6 1982 Oyer Well Leflore
 date well completed firm name county well located

LANDOWNER: Morris

description of formations encountered from to

(mailing address)

CLAY 0 22
5' in SAND 22 43
SAND Gravel 43- 113

WELL LOCATION:
 sec. 13 T 20 N R 1 E
7 miles NE of G'wood
 (distance) (direction) (nearest town)

WELL PURPOSE:
 (home, irrigation, municipal, industrial)

WELL COMPLETION DATA:

- (1) diameter (inches) 14
- (2) total depth (feet) 113
- (3) static water level (feet) 9 below above top of ground.
- (4) casing Steel 73
 (material) (depth)
- 16 If telescope see back.
 (size)
- (5) screen 40 73
 (length) (depth to top)
- 16 Mild Steel
 (size) (material)
- (6) pump 60 3000
 (HP) (yield gpm)
- Diesel
 (type power)
- (7) electric log No
 (yes or no)
- NONE
 (organization running log)
- (8) how well bottom plugged Plate

DRILLERS REMARKS:


DEPT. OF NATURAL RESOURCES
 BUREAU OF LAND & WATER RESOURCES

MAY 14 1982

RECEIVED

If well telescopes please sketch and show depths.

GROUND LEVEL

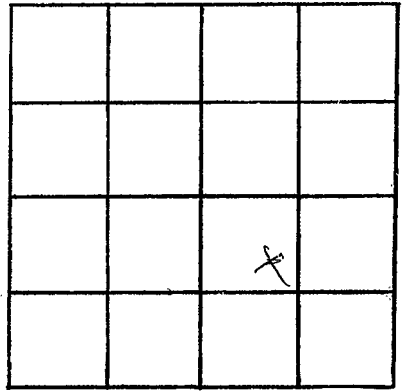

SECTION 13

Please indicate well location X.

ADDITIONAL INFORMATION

If more than one screen,
show locations of each on sketch.