

MISSISSIPPI DEPARTMENT OF NATURAL RESOURCES

Bureau of Land and Water Resources

Southport Mall

P.O. Box 10631

Jackson, Mississippi 39209

WATER WELL DRILLERS LOG

Leflore
H100

date well completed 5/82 firm name Dyer Well county well located Leflore

LANDOWNER: Morris

(mailing address)

description of formations encountered	from	to
<u>Clay</u>	<u>0</u>	<u>22</u>
<u>Fine Sand</u>	<u>22</u>	<u>35</u>
<u>Sand</u>	<u>35</u>	<u>48</u>
<u>Sand Gravel</u>	<u>48</u>	<u>108</u>

WELL LOCATION:
sec. 15 T 20 N R. 1 E
6 miles NW of R. Wood
(distance) (direction) (nearest town)

WELL PURPOSE:
(home, irrigation, municipal, industrial)

WELL COMPLETION DATA:

(1) diameter (inches) 16

(2) total depth (feet) 108

(3) static water level (feet) 9 below above top of ground.

(4) casing Steel 58,
(material) (depth)

16 If telescope see back.
(size)

(5) screen 40, 68
(length) (depth to top)

16, Mild Steel
(size) (material)

(6) pump 60 3000
(HP) (yield gpm)

Diesels
(type power)

(7) electric log NO
(yes or no)

(organization running log) None

(8) how well bottom plugged Plates

DRILLERS REMARKS:


DEPT. OF NATURAL RESOURCES
BUREAU OF LAND & WATER RESOURCES

MAY 14 1982

RECEIVED

If well telescopes please sketch and show depths.

GROUND LEVEL

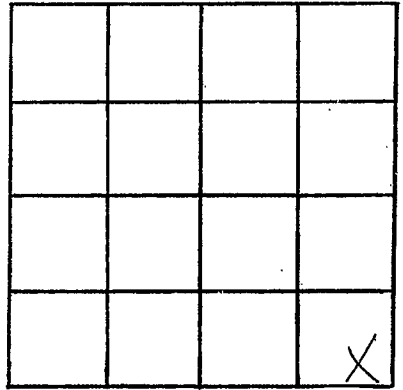

SECTION 15

Please indicate well location X.

ADDITIONAL INFORMATION

If more than one screen,
show locations of each on sketch.