

MISSISSIPPI DEPARTMENT OF NATURAL RESOURCES

Bureau of Land and Water Resources

Southport Mall

P.O. Box 10631

CODED

Jackson, Mississippi 39209

WATER WELL DRILLERS LOG

Leflore
A 101

5 19 82 *Dyer Well* *Leflore*
 date well completed firm name county well located

LANDOWNER: *Morris*

description of formations encountered	from	to
<i>Clay</i>	<i>0</i>	<i>22</i>
<i>Fine Sand</i>	<i>22</i>	<i>35</i>
<i>Sand</i>	<i>35</i>	<i>48</i>
<i>Sand & Gravel</i>	<i>48</i>	<i>103</i>

(mailing address)

WELL LOCATION:

sec. *22* T *20* N R *1* E
5 miles *NW* of *G Wood*
 (distance) (direction) (nearest town)

WELL PURPOSE:

(home, irrigation, municipal, industrial)

WELL COMPLETION DATA:

- (1) diameter (inches) *10*
- (2) total depth (feet) *103*
- (3) static water level (feet) *9* below above top of ground.
- (4) casing *10* *63*
 (material) (depth)
10 if telescope see back.
 (size)
- (5) screen *steel* *40*
 (length) (depth to top)
10 *MILD STEEL*
 (size) (material)
- (6) pump *30* *1500*
 (HP) (yield gpm)
Diesel
 (type power)
- (7) electric log *NO*
 (yes or no)
NONE
 (organization running log)
- (8) how well bottom plugged *Plate*

DEPT. OF NATURAL RESOURCES
 BUREAU OF LAND & WATER RESOURCES


MAY 14 1982

DRILLERS REMARKS:

RECEIVED

If well telescopes please sketch and show depths.

GROUND LEVEL

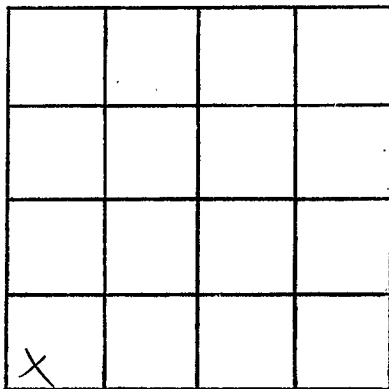

SECTION 22

Please indicate well location X.

ADDITIONAL INFORMATION

If more than one screen,
show locations of each on sketch.