

MISSISSIPPI DEPARTMENT OF NATURAL RESOURCES

Bureau of Land and Water Resources

Southport Mall

P.O. Box 10631

CODED

Jackson, Mississippi 39209

WATER WELL DRILLERS LOG

*Leflore*  
*H102*

date well completed *5-13 1982* firm name *Dyer Well* county well located *Leflore*

LANDOWNER: *Ronald Conway*

description of formations encountered

from to

*Clay* *0* *58*  
*Sand & Gravel* *58* *100*

(mailing address)

WELL LOCATION:

sec. *11* T *20* (N) R *1* (E)  
*4* miles *se* of *Money*  
 (distance) (direction) (nearest town)

WELL PURPOSE:

(home, irrigation, municipal, industrial)

WELL COMPLETION DATA:

- (1) diameter (inches) *16*
- (2) total depth (feet) *100*
- (3) static water level (feet) *15* below above top of ground.
- (4) casing *steel* *80*  
 (material) (depth)  
*16* if telescope see back.  
 (size)
- (5) screen *40* *60*  
 (length) (depth to top)  
*16* *Mild Steel*  
 (size) (material)
- (6) pump *60* *3000*  
 (HP) (yield gpm)  
*diesel*  
 (type power)
- (7) electric log *NO*  
 (yes or no)

(organization running log)

(8) how well bottom plugged *plate*

DRILLERS REMARKS:


DEPT. OF NATURAL RESOURCES  
 BUREAU OF LAND & WATER RESOURCES

SEP 30 1982

RECEIVED

If well telescopes please sketch and show depths.

GROUND LEVEL

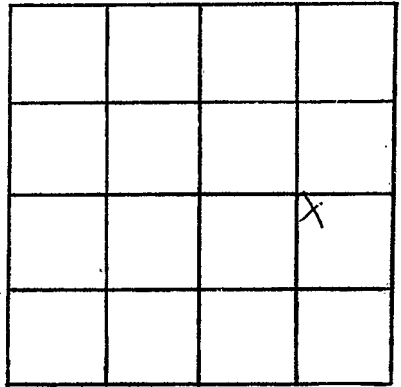

SECTION 11

Please indicate well location X.

ADDITIONAL INFORMATION

If more than one screen,  
show locations of each on sketch.