

MISSISSIPPI DEPARTMENT OF NATURAL RESOURCES

Bureau of Land and Water Resources

Southport Mall

P.O. Box 10631

Jackson, Mississippi 39209

WATER WELL DRILLERS LOG

CODED

LEFLORE  
H 104  
GW 04009

6-19-86 19 IRRIGATION EQUIPMENT Leflore  
 date well completed firm name county well located

LANDOWNER: FHA\*  
200 EAST WASHINGTON  
GREENWOOD, MS 38930  
 (mailing address)

description of formations encountered	from	to
clay	0	10
fine sand	10	25
coarse sand / pebbles	25	88

WELL LOCATION:  
 sec. 25 T 20 N R 1 E  
6 miles NNE of GREENWOOD  
 (distance) (direction) (nearest town)

WELL PURPOSE: PIVOT  
 (home, irrigation, municipal, industrial)

WELL COMPLETION DATA:

(1) diameter (inches) 16"

(2) total depth (feet) 88

(3) static water level (feet) 30 below top of ground. above

(4) casing Steel 48'  
 (material) (depth)  
16" if telescope see back.  
 (size)

(5) screen 40' 48'  
 (length) (depth to top)  
16" STEEL  
 (size) (material)

(6) pump 100 1600  
 (HP) (yield gpm)  
Diesel  
 (type power)

(7) electric log NO  
 (yes or no)

(organization running log)

(8) how well bottom plugged steel plate

\* USFWS / MS Wetland Management District

CODED


RECEIVED  
 JUL 30 1986

Department of Natural Resources  
 Bureau of Land & Water Resources

DRILLERS REMARKS: Temp. permit  
# 86169KSE01

If well telescopes please sketch and show depths.

GROUND LEVEL

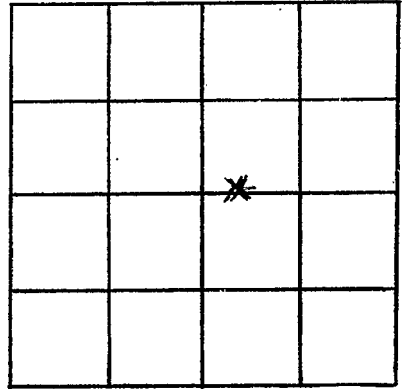

SECTION 25

Please indicate well location X.

ADDITIONAL INFORMATION

If more than one screen,  
show locations of each on sketch.