

MISSISSIPPI DEPARTMENT OF NATURAL RESOURCES

Bureau of Land and Water Resources

Southport Mall

P.O. Box 10631

Jackson, Mississippi 39209

WATER WELL DRILLERS LOG

LEFLORE
H 107
GW6866

CODED

5/21 1987 BUTANE GAS CO. OF GREENWOOD Leflore
date well completed firm name county well located

LANDOWNER:	description of formations encountered	from	to
T. J. GARY	Clay	0	20
Greenwood (mailing address)	SAND & GRAVEL	20	93
WELL LOCATION:			
sec. <u>6</u> T. <u>20</u> (N) R. <u>1</u> (E) <u>1 1/2</u> miles <u>SW</u> of <u>MAURY</u> (distance) (direction) (nearest town)			
WELL PURPOSE: <u>TRR</u> (home, irrigation, municipal, industrial)			
WELL COMPLETION DATA:			
(1) diameter (inches) <u>12</u>			
(2) total depth (feet) <u>93</u>			
(3) static water level (feet) <u>20</u> below top of ground.			
(4) casing <u>Steel</u> , <u>53</u> , (material) (depth), <u>12"</u> if telescope see back. (size)			
(5) screen <u>40"</u> , <u>53</u> (length) (depth to top)			
(6) pump <u>60</u> , <u>Steel</u> (HP) (yield gpm)			
<u>ELEC.</u> (type power)			
(7) electric log <u>No</u> (yes or no)			
(organization running log)			
(8) how well bottom plugged			
<u>Steel Plate</u>			
DRILLERS REMARKS:			

Permit # **CODED**

GW6866-LAR-04-24-87
OK


RECEIVED

JUN 03 1987

Department of Natural Resources
Bureau of Land & Water Resources

If well telescopes please sketch and show depths.

GROUND LEVEL

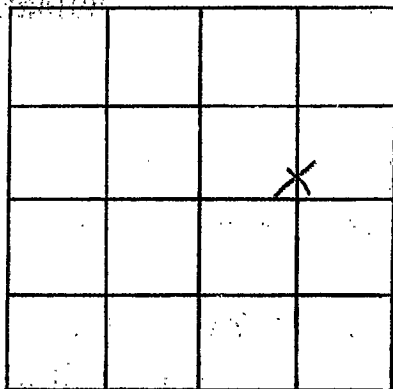

SECTION 6

Please indicate well location X.

ADDITIONAL INFORMATION

If more than one screen,
show locations of each on sketch.