

MISSISSIPPI DEPARTMENT OF NATURAL RESOURCES

Bureau of Land and Water Resources

Southport Mall

P.O. Box 10631

Jackson, Mississippi 39209

WATER WELL DRILLERS LOG

CODED

LEFLORE
H/08
GW 216

5-11 1987 BUTANE GAS CO. OF GREENWOOD Leflore
date well completed firm name county well located

LANDOWNER:	description of formations encountered	from	to
Whittington Planting Co.			
Greenwood (mailing address)	Clay	0	10
	SAND	10	35
	SAND + GRAVEL	35	103
WELL LOCATION:			
sec. 33 T 20 N R 1 E S W			
1 miles NORTH of GREENWOOD (distance) (direction) (nearest town)			
WELL PURPOSE: IRRIGATION (home, irrigation, municipal, industrial)			
WELL COMPLETION DATA:			
(1) diameter (inches) 16			
(2) total depth (feet) 103			
(3) static water level (feet) 20 below top of ground. above			
(4) casing Steel, 63 (material) (depth)			
16 (size) If telescope see back.			
(5) screen 40, 63 (length) (depth to top)			
16" Steel (size) (material)			
(6) pump 24, 1200 (HP) (yield gpm)			
Diesel (type power)			
(7) electric log No (yes or no)			
(organization running log)			
(8) how well bottom plugged Steel Plate			
DRILLERS REMARKS:			

CODED


RECEIVED

JUN 03 1987

Department of Natural Resources
Bureau of Land & Water Resources

If well telescopes please sketch and show depths.

GROUND LEVEL

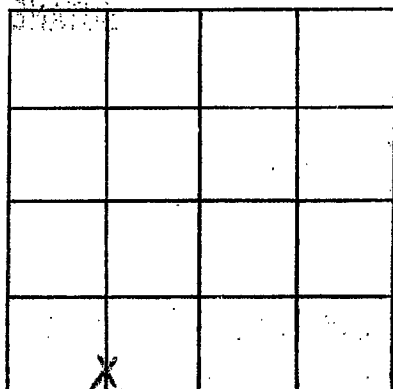

SECTION 33

Please indicate well location X.

ADDITIONAL INFORMATION

If more than one screen, show locations of each on sketch.