

CODED

MISSISSIPPI DEPARTMENT OF NATURAL RESOURCES

Bureau of Land and Water Resources

P.O. Box 10631

Jackson, Mississippi 39209

WATER WELL DRILLERS LOG

COUNTY WELL LOCATED	DeFlore	
WELL NUMBER	# 109	CODED
DATE WELL COMPLETED	7-19-88	

PERMIT NUMBER	GW 11111
NAME OF DRILLING FIRM	J & K IRRIGATION

NAME & MAILING ADDRESS OF LANDOWNER	Mrs. Gene Neil Greenwood, Miss		
WELL LOCATION: SEC	TOWNSHIP	RANGE	
	67	20	1
DISTANCE	DIRECTION	NEAREST TOWN	
5 1/2 Miles	E	Money	
OTHER LANDMARK			
WELL PURPOSE: Home, Irrigation, Municipal, Industrial, Fish Pond, etc.	<input checked="" type="checkbox"/> Irrigation		

PUMP DATA		
PUMP TYPE (Circle One):	Submersible, <input checked="" type="checkbox"/> Turbine, Jet, Flowing Well, Other (Describe)	
POWER TYPE (Circle One):	Electric, Tractor, <input checked="" type="checkbox"/> Diesel, Gasoline, Butane, Other (Describe)	
Pump Capacity (GPM)	No. of Stages	Setting Depth
1800	3	60 FT.
PUMP TEST		
Well yielded	1800	GPM with a drawdown of 22 ft. after _____ hours of pumping

WELL DATA		
Well Depth	Casing Diameter (In.)	Casing Length (Ft.)
97	16"	2957
Type of Casing	Hole Depth	Depth to Static Water Level
Steel	97	17
TYPE OF COMPLETION: (Circle One or More):		
<input checked="" type="checkbox"/> Gravel Packed, <input type="checkbox"/> Underreamed, <input type="checkbox"/> Telescoped, <input type="checkbox"/> Natural Development, <input type="checkbox"/> Open Hole, <input type="checkbox"/> Other (Describe)		
Top of Lap Pipe or Reduction in Casing		
FEET	IF TELESCOPED OR MORE THAN ONE SCREEN: USE BACK PAGE	

LOG DATA	
TYPE OF LOG RUN (Circle One):	No Log Run, Electric, Gamma Ray, Density, Sonic, Neutron, Other (Describe)
Name of Organization Running Log	

SCREEN DATA		
Diameter - Inches	Length - Feet	Slot Size - Inches
16	40	.030
Screen Type	Depth to Bottom - Feet	
Steel	97	

GEOLOGIC DATA (Office Use Only)			
Surface Elev.	Geologic Unit	Unit Thickness	Depth to Top
Subs. SWL	Date	Analysis	Aquifer Test
Driller's Remarks			

DESCRIPTION OF FORMATIONS ENCOUNTERED	FROM	TO	FROM	TO
Clay	0	15		
Fine Sand	15	37		
Sand & Gravel	37	97		

RECEIVED


SEP 14 1988

Department of Natural Resources
Bureau of Land & Water Resources

IF MORE SPACE IS NEEDED, USE BACK.

If well telescopes please sketch and show depths.

GROUND LEVEL

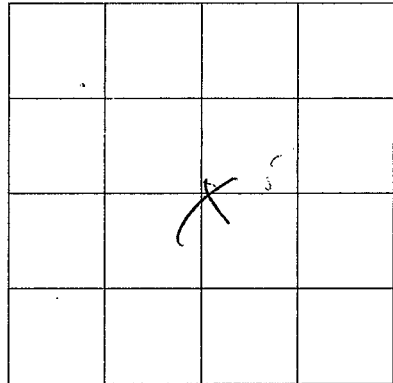

SECTION 6

Please indicate well location X.

ADDITIONAL INFORMATION

If more than one screen,
show location of each on sketch.